


North

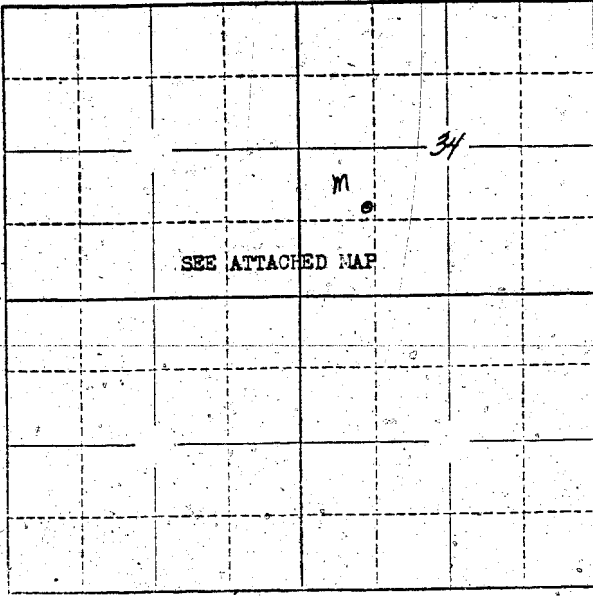

Locate well and acreage of irrigated land on plat.

Scale: 2" = 1 Mile

STATE OF OREGON

County of Marion

ss.

I, Allen and Elizabeth Schlabach, being first duly sworn, do hereby certify that I have read the foregoing Registration Statement and that all of the items therein contained are true to the best of my knowledge and belief.

Allen Schlabach
(Signature of Registrant)

Subscribed and sworn to before me this 1st day of August, 1958

My commission expires Sept. 8, 1960

Chris L. Schuler
(Notary Public)

(SEAL)

CERTIFICATE OF REGISTRATION

STATE OF OREGON

County of Marion

ss.

This is to certify that the foregoing Registration Statement was received in the office of the State Engineer on the 1st day of August, 1958, at 1⁰⁰ o'clock P. M. and has been duly recorded in said office in Book No. 15 of Registration Statements on page GR-3515

~~xx Construction shall be completed by 10/1/59 and the water completely applied to beneficial use by 12/31/59 xx~~

Witness my hand this 15th day of September, 1959

Alvin A. Hart
(State Engineer)

\$15.00

By

(Deputy)

GR-3515