


Township 83 Range 34 W.M.

North

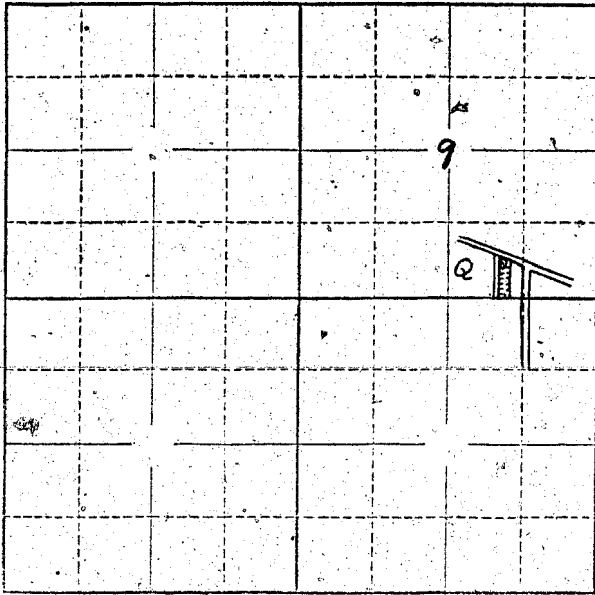

Locate well and acreage of irrigated land on plat.  
Scale: 2" = 1 Mile

STATE OF OREGON

County of Marion } ss.

I, Mervin Sawyer being first duly sworn, do hereby certify that I have read the foregoing Registration Statement and that all of the items therein contained are true to the best of my knowledge and belief.

Mervin Sawyer  
(Signature of Registrant)

Subscribed and sworn to before me this 31st day of July, 1958

My commission expires Feb 18, 1959 Michael E Lane  
(Notary Public)

(SEAL)

**CERTIFICATE OF REGISTRATION**

STATE OF OREGON }  
County of Marion } ss.

This is to certify that the foregoing Registration Statement was received in the office of the State Engineer on the 4th day of August, 1958, at 2:00 o'clock A.M. and has been duly recorded in said office in Book No. 15 of Registration Statements on page GR 3528

~~Construction shall be completed by 12:00 p.m. and the water completely applied to beneficial use by 12:00 p.m.~~

Witness my hand this 15th day of September, 1959

Paul A. Stanley  
(State Engineer)

By \_\_\_\_\_  
(Deputy)

\$15.00

GR-3528