


Township 10 S Range 4 W, W.M.

North

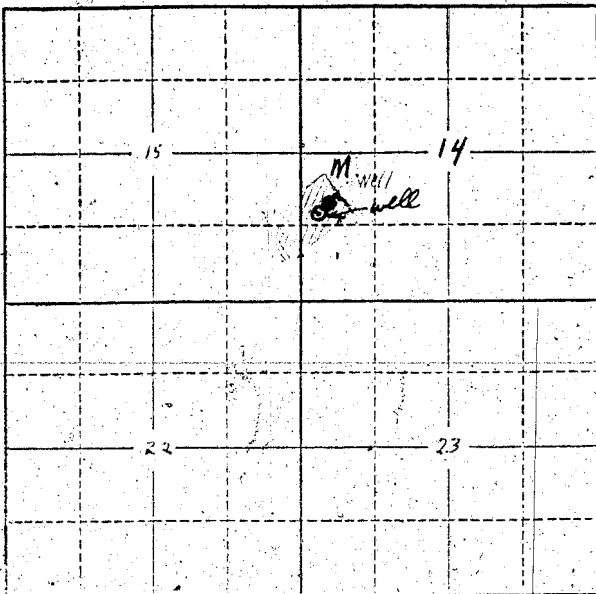

Locate well and acreage of irrigated land on plat.

Scale: 2" = 1 Mile

STATE OF OREGON

County of

ss.

I,, being first duly sworn, do hereby certify that I have read the foregoing Registration Statement and that all of the items therein contained are true to the best of my knowledge and belief.

Earl Garrison
(Signature of Registrant)

Subscribed and sworn to before me this 1 day of August, 1958

My commission expires MY COMMISSION EXPIRES MAY 26, 1960

Leelan E. Phillips
(Notary Public)

(SEAL)

CERTIFICATE OF REGISTRATION

STATE OF OREGON

County of Marion

ss.

This is to certify that the foregoing Registration Statement was received in the office of the State Engineer on the 4 day of August, 1958, at 8:00 o'clock A. M. and has been duly recorded in said office in Book No. 15 of Registration Statements on page GR-3541

~~xx Construction shall be completed by~~

~~beneficial to by~~

Witness my hand this 15th day of September, 1959

Laura A. Stanley
(State Engineer)

By

(Deputy)

GR-3541

\$15.00