Township 11 S Range [redacted] 4W, W.M.

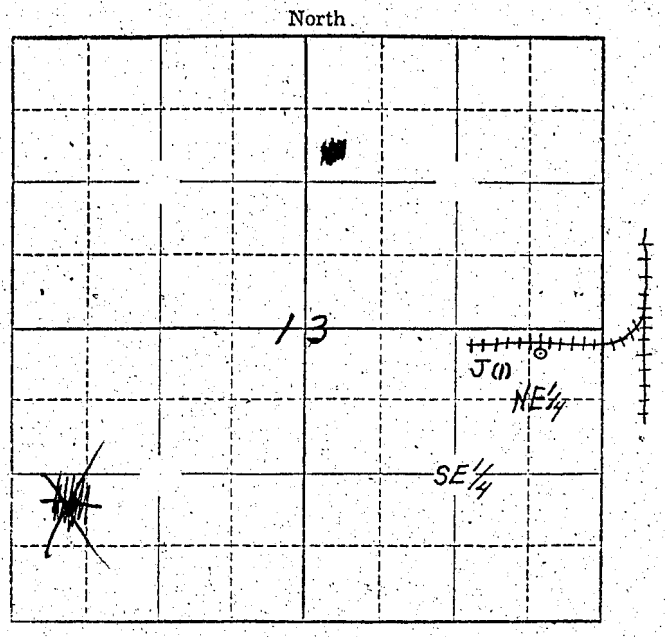

Locate well and acreage of irrigated land on plat.

Scale: ■ = 1 Mile

STATE OF OREGON
County of Linn } ss.

I, [redacted], being first duly sworn, do hereby certify that I have read the foregoing Registration Statement and that all of the items therein contained are true to the best of my knowledge and belief.

[redacted]
(Signature of Registrant)

Subscribed and sworn to before me this 27th day of March, 1957

My commission expires May 26, 1958 [redacted]
(Notary Public)

(SEAL)

CERTIFICATE OF REGISTRATION

STATE OF OREGON
County of Marion } ss.

This is to certify that the foregoing Registration Statement was received in the office of the State Engineer on the 8th day of March, 1957, at 8:00 o'clock A. M. and has been duly recorded in said office in Book No. 4 of Registration Statements on page GR-625 C.

~~Construction shall be completed by x-x-x-x-x-x-x-x-x-x-19 x-x, and the water used completely applied to beneficial use by x-x-x-x-x-x-x-x-x-x-19 x-x~~

Witness my hand this 27th day of November, 1957

LEWIS A. STANLEY
(State Engineer)

$20.00

By [redacted]
(Deputy)

GR-625 C