


Township 1N Range 3E, W.M.
North

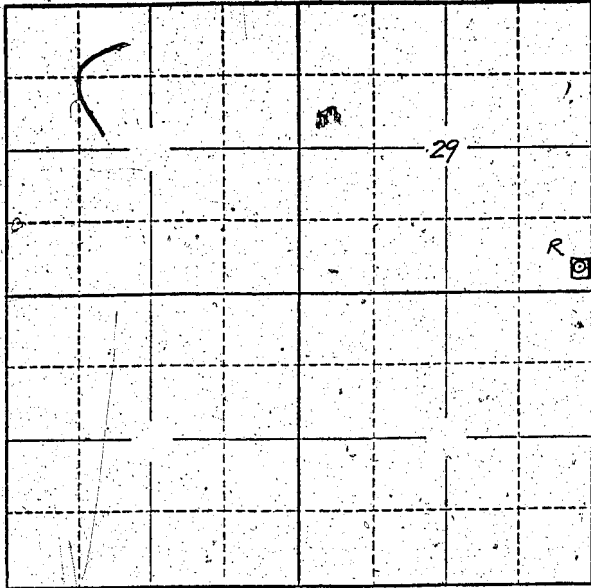

Locate well and acreage of irrigated land on plat.
Scale: 2" = 1 Mile

STATE OF OREGON

County of Wheeler } ss.

I, Rich A. Lamm, being first duly sworn, do hereby certify that I have read the foregoing Registration Statement and that all of the items therein contained are true to the best of my knowledge and belief.

Rich A. Lamm
(Signature of Registrant)

Subscribed and sworn to before me this 12th day of Aug, 1958

NOTARY PUBLIC FOR OREGON
MY COMMISSION EXPIRES JAN. 9, 1961

My commission expires

Walter H. Wood
(Notary Public)

(SEAL)

CERTIFICATE OF REGISTRATION

STATE OF OREGON

County of Marion } ss.

This is to certify that the foregoing Registration Statement was received in the office of the State Engineer on the 21st day of August, 1958, at 1:00 o'clock A. M. and has been duly recorded in said office in Book No. 16 of Registration Statements on page GR 4003

Witness my hand this 15th day of March, 1960

Walter H. Wood
(State Engineer)

By _____ (Deputy)

GR 4003

\$15.00