


Township 45 Range 24.W. W.M.
North

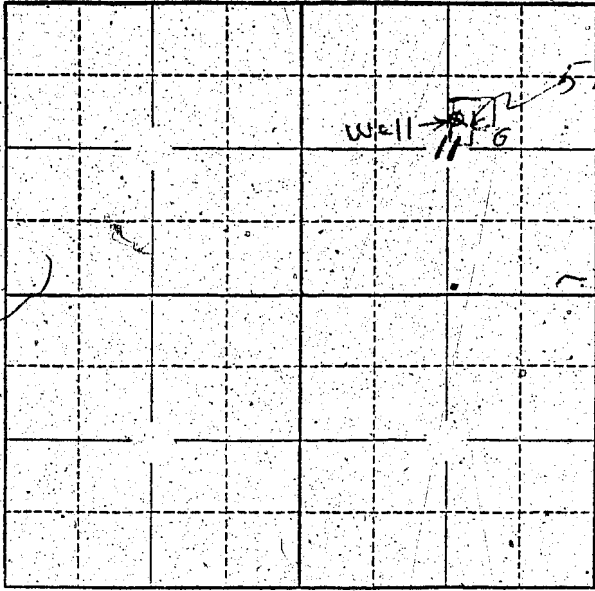

Locate well and acreage of irrigated land on plat.
Scale: 2" = 1 Mile

STATE OF OREGON }
County of Hamhill } ss.

I, Edw. Hoem Jr, being first duly sworn, do hereby certify that I have read the foregoing Registration Statement and that all of the items therein contained are true to the best of my knowledge and belief.

Edw. Hoem Jr
(Signature of Registrant)

Subscribed and sworn to before me this 1 day of August, 1958.

My commission expires 10/20/60
Thomas A. Bennett
(Notary Public)

(SEAL)

CERTIFICATE OF REGISTRATION

STATE OF OREGON }
County of Marion } ss.

This is to certify that the foregoing Registration Statement was received in the office of the State Engineer on the 4 day of August, 1958, at 5:00 o'clock A. M. and has been duly recorded in said office in Book No. 16 of Registration Statements on page GR-3814

Witness my hand this 4th day of December, 1959.

Laura A. Stanley
(State Engineer)

By _____
(Deputy)

GR 3814

#15.00