


Township 17. S Range R. 9 <sup>W.M.</sup> 18. E, W.M.  
North

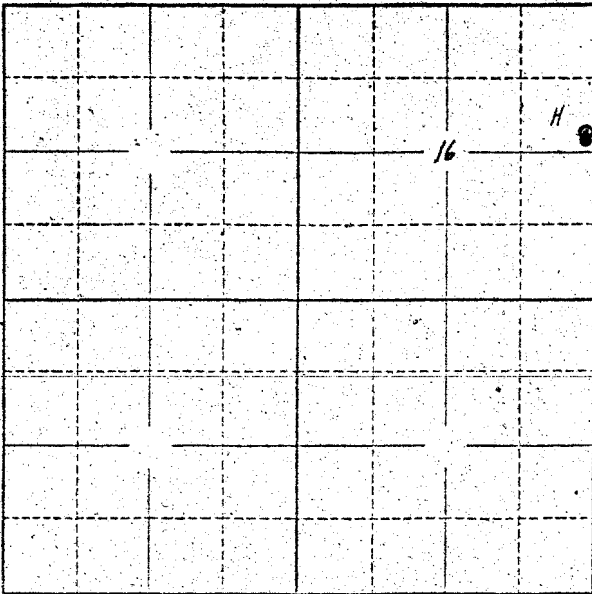

Locate well and acreage of irrigated land on plat.  
Scale: 2" = 1 Mile

STATE OF OREGON }  
County of Lane } ss.

I, \_\_\_\_\_, being first duly sworn, do hereby certify that I have read the foregoing Registration Statement and that all of the items therein contained are true to the best of my knowledge and belief.

Ellen Marie Pruitt  
(Signature of Registrant)

Subscribed and sworn to before me this 1st day of August, 1958

My commission expires \_\_\_\_\_  
NOTARY PUBLIC FOR OREGON  
My Commission Expires Oct. 16, 1959

Robert G. Iwan  
(Notary Public)

(SEAL)

**CERTIFICATE OF REGISTRATION**

STATE OF OREGON }  
County of Marion } ss.

This is to certify that the foregoing Registration Statement was received in the office of the State Engineer on the 4<sup>th</sup> day of August, 1958, at 2:00 o'clock A. M. and has been duly recorded in said office in Book No. 15 of Registration Statements on page GR 3551

Witness my hand this 15<sup>th</sup> day of September, 1959

Laura A. Stanley  
(State Engineer)

By \_\_\_\_\_  
(Deputy)

\$15.00