


Township 15 Range 10W W.M.
North

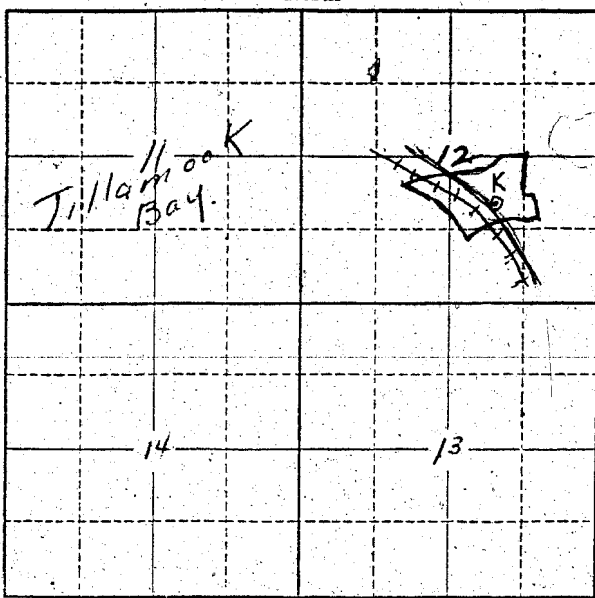

Locate well and acreage of irrigated land on plat.
Scale: 2" = 1 Mile

STATE OF OREGON

County of Tillamook } ss.

I, Anna Nielsen Toland, being first duly sworn, do hereby certify that I have read the foregoing Registration Statement and that all of the items therein contained are true to the best of my knowledge and belief,

Anna Nielsen Toland
(Signature of Registrant)

Subscribed and sworn to before me this 4 day of August, 1958

My commission expires 4-6-59
H. C. Clavin
(Notary Public)

(SEAL)

CERTIFICATE OF REGISTRATION

STATE OF OREGON } ss.
County of Marion

This is to certify that the foregoing Registration Statement was received in the office of the State Engineer on the 4 day of August, 1958, at 8:00 o'clock A. M. and has been duly recorded in said office in Book No. 15 of Registration Statements on page GR 3555.

Witness my hand this 15th day of September, 1959

Lewis A. Stanley
(State Engineer)

\$15.90

By _____
(Deputy)