Township 6 N Range 35 E, W.M.

North

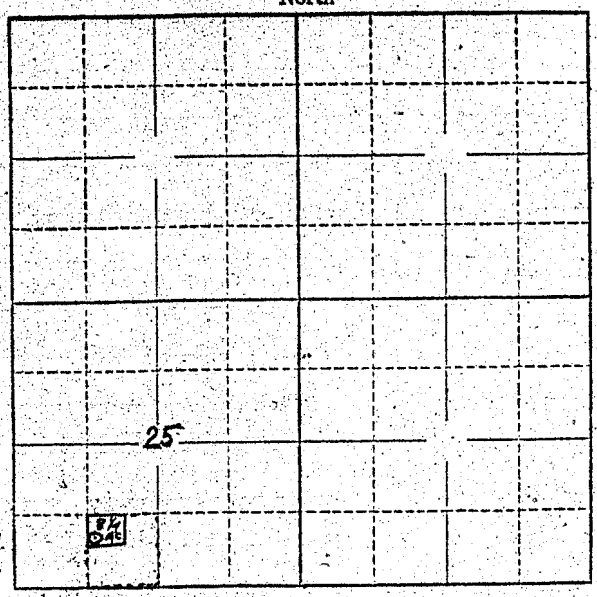

at a point 317.03 south from a pt. 76 ft. East from NW Cor of SE 1/4 of SW 1/4 of Sec. 25 Tp 6 N. E.W.M.

Locate well and acreage of irrigated land on plat.

Scale: 2" = 1 Mile

Well

STATE OF OREGON }ss.
County of Umatilla

I, Gladys Kniffong, being first duly sworn, do hereby certify that I have read the foregoing Registration Statement and that all of the items therein contained are true to the best of my knowledge and belief.

Gladys Kniffong
(Signature of Registrant)

Subscribed and sworn to before me this 8 day of March, 1957

My commission expires March 21, 1959

R. H. Dillman
(Notary Public)

(SEAL)

CERTIFICATE OF REGISTRATION

STATE OF OREGON }ss.
County of Marion

This is to certify that the foregoing Registration Statement was received in the office of the State Engineer on the 11th day of March, 1957, at 8:00 o'clock A.M. and has been duly recorded in said office in Book No. 3 of Registration Statements on page GR-378 C

~~Construction shall be completed by X-X-X-X-X-X-X-X-X-X-X-X-X-X and the water could be applied to beneficial use by X-X-X-X-X-X-X-X-X-X, 19 X-X~~

Witness my hand this 30th day of April, 1957

Lewis A. Stanley
(State Engineer)

By
(Deputy)

GR 378 C