


Township 145 Range 5W, W.M.  
North

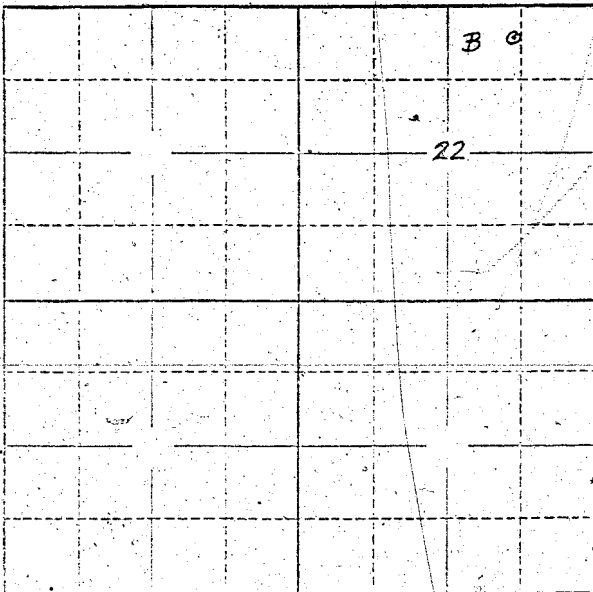

Locate well and acreage of irrigated land on plat.  
Scale: 2" = 1 Mile

STATE OF OREGON

County of Benton } ss.

I, Arnold Eberlein, being first duly sworn, do hereby certify that I have read the foregoing Registration Statement and that all of the items therein contained are true to the best of my knowledge and belief.

Arnold Eberlein  
(Signature of Registrant)

Subscribed and sworn to before me this 30<sup>th</sup> day of July, 1958.

My commission expires May 22, 1961

Leora B. Turner  
(Notary Public)

(SEAL)

### CERTIFICATE OF REGISTRATION

STATE OF OREGON

County of Marion } ss.

This is to certify that the foregoing Registration Statement was received in the office of the State Engineer on the 1st day of August, 1958, at 2:00 o'clock A. M. and has been duly recorded in said office in Book No. 15 of Registration Statements on page GR-3562

~~Conservation shall be observed by and the water completely applied to beneficial uses by~~

Witness my hand this 15<sup>th</sup> day of September, 1959.

Clara A. Stanley  
(State Engineer)

By

(Deputy)

GR-3562

\$15.00