


Township CN Range 35E, W.M.
North

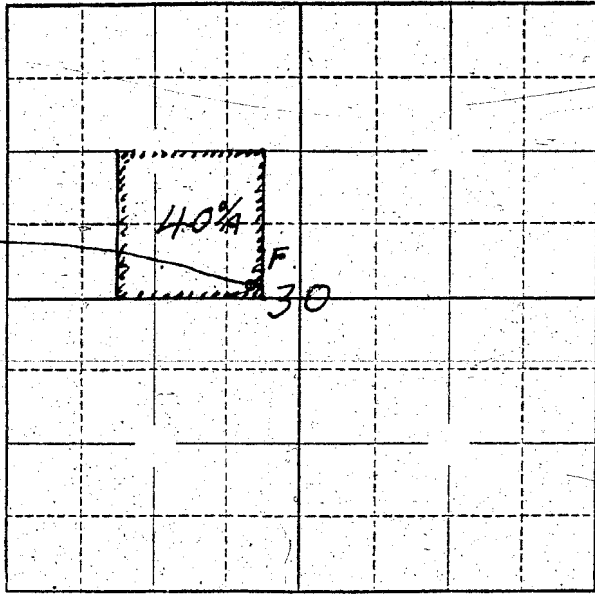

Well Location
370 feet west +
30' N of center
of Sec 30

Locate well and acreage of irrigated land on plat.

Scale: ~~1/2~~ - 1 Mile

STATE OF OREGON

County of Marion } ss.

I, Katie Limbach being first duly sworn, do hereby certify that I have read the foregoing Registration Statement and that all of the items therein contained are true to the best of my knowledge and belief.

Katie Limbach
(Signature of Registrant)

Subscribed and sworn to before me this 31 day of July, 1958

My commission expires 1/23/62, G.H. Bishop
(Notary Public)

(SEAL)

CERTIFICATE OF REGISTRATION

STATE OF OREGON }
County of Marion } ss.

This is to certify that the foregoing Registration Statement was received in the office of the State Engineer on the 4th day of August, 1958, at 8:00 o'clock A. M. and has been duly recorded in said office in Book No. 15 of Registration Statements on page GR-3565

Witness my hand this 15th day of September, 1959

Laura A. Stanley
(State Engineer)

By _____
(Deputy)

\$16.50

GR 3565