


Township 6 N Range 35 E W.M.  
North

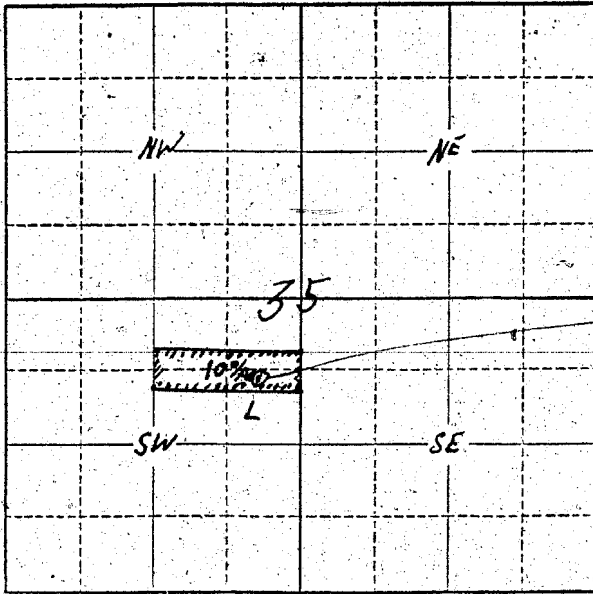

Well location  
488.5 feet West  
& 815 feet South  
of center of Sec  
35.

Locate well and acreage of irrigated land on plat.  
Scale: 2" = 1 Mile

STATE OF OREGON

County of Timathia } ss.

I, Hea, being first duly sworn, do hereby certify that I have read the foregoing Registration Statement and that all of the items therein contained are true to the best of my knowledge and belief.

X Hea  
(Signature of Registrant)

Subscribed and sworn to before me this 31 day of July, 1958

My commission expires 1/26/62

[Signature]  
(Notary Public)

(SEAL)

**CERTIFICATE OF REGISTRATION**

STATE OF OREGON } ss.  
County of Marion

This is to certify that the foregoing Registration Statement was received in the office of the State Engineer on the 4th day of August, 1958, at 8:00 o'clock A. M. and has been duly recorded in said office in Book No. 15 of Registration Statements on page GR-3570

Witness my hand this 15th day of September, 1959

[Signature]  
(State Engineer)

By \_\_\_\_\_ (Deputy)

\$ 15.00