


Township 14 S Range 5 W W.M. North

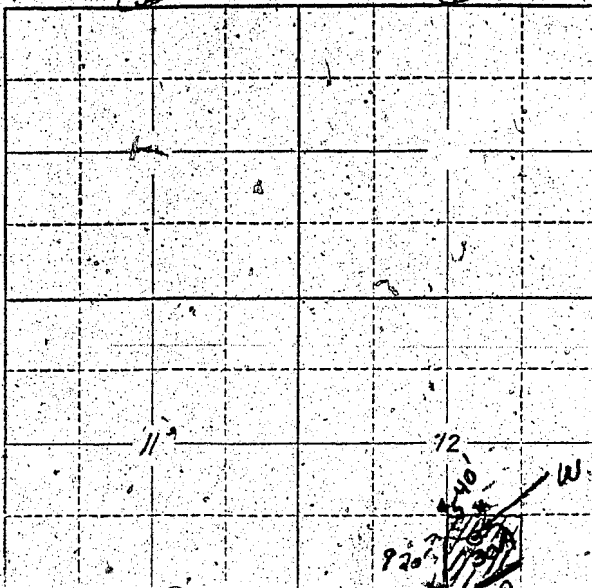

Locate well and acreage of irrigated land on plat.

Scale: 2" = 1 Mile

1/2 section corner

STATE OF OREGON

County of Denton

ss.

I, Paul Rigor, being first duly sworn, do hereby certify that I have read the foregoing Registration Statement and that all of the items therein contained are true to the best of my knowledge and belief.

Subscribed and sworn to before me this 7<sup>th</sup> day of March, 1957

Paul Rigor  
(Signature of Registrant)

My commission expires PUBLIC FOR OREGON

My Commission Expires March 29, 1960

Ernie J. Gault  
(Notary Public)

(SEAL)

CERTIFICATE OF REGISTRATION

STATE OF OREGON

County of Marion

ss.

This is to certify that the foregoing Registration Statement was received in the office of the State Engineer on the 12<sup>th</sup> day of March, 1957, at 8:00 o'clock A. M. and has been duly recorded in said office in Book No. 16 of Registration Statements on page GR-3969

~~Construction shall be completed by ... and the water completely applied to the official use of ...~~

Witness my hand this 15<sup>th</sup> day of February, 1960

Laura A. Stoney  
(State Engineer)

\$15.00

By

GR-3969

(Deputy)