


Township 25 Range 2E, W.M.  
North

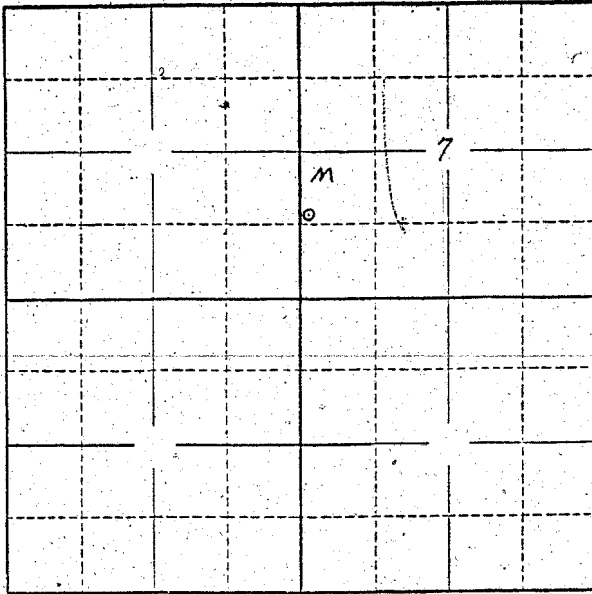

Locate well and acreage of irrigated land on plat.  
Scale: 2" = 1 Mile

STATE OF OREGON

County of Clackamas } ss.

I, Arthur C. Wright, being first duly sworn, do hereby certify that I have read the foregoing Registration Statement and that all of the items therein contained are true to the best of my knowledge and belief.

Arthur C. Wright  
(Signature of Registrant)

Subscribed and sworn to before me this 30th day of July, 19 58.

My Commission Expires Dec. 11, 1959

My commission expires \_\_\_\_\_

Joseph W. Cook  
(Notary Public)

(SEAL)

**CERTIFICATE OF REGISTRATION**

STATE OF OREGON } ss.  
County of Marion

This is to certify that the foregoing Registration Statement was received in the office of the State Engineer on the 4th day of August, 1958, at 8:00 o'clock A.M. and has been duly recorded in said office in Book No. 15 of Registration Statements on page GR-3577.

Witness my hand this 15th day of September, 19 59.

Lewis A. Stanley  
(State Engineer)

By \_\_\_\_\_ (Deputy)

GR 3577

\$15.00