


Township 18.5 Range 2W W.M.
North

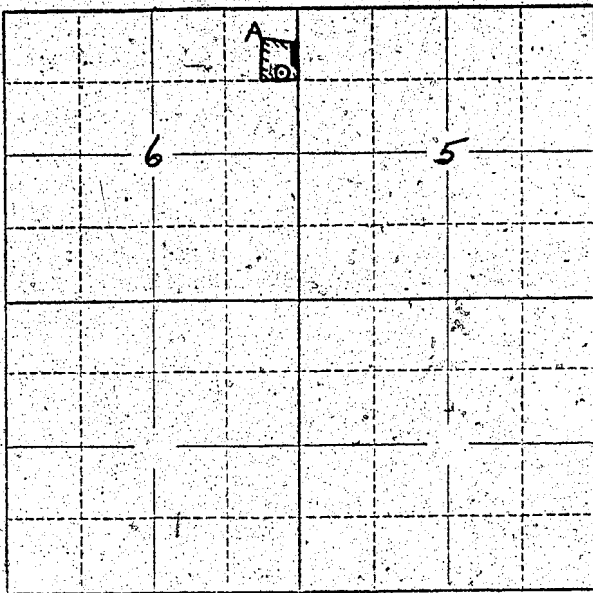

Locate well and acreage of irrigated land on plat.

Scale: 2" = 1 Mile.

STATE OF OREGON

County of Washington

ss.

I, Mr. J. Mills, being first duly sworn, do hereby certify that I have read the foregoing Registration Statement and that all of the items therein contained are true to the best of my knowledge and belief.

Mr. J. Mills
(Signature of Registrant)

Subscribed and sworn to before me this 30 day of July, 1953

My commission expires 4-19-62

Everett K. ...
(Notary Public)

(SEAL)

CERTIFICATE OF REGISTRATION

STATE OF OREGON

County of Marion

ss.

This is to certify that the foregoing Registration Statement was received in the office of the State Engineer on the 4 day of August, 1953, at 8:00 o'clock A.M. and has been duly recorded in said office in Book No. 17 of Registration Statements on page GR-4071

~~Construction shall be completed by ... and the order completely applied to ...~~

Witness my hand this 16th day of May, 1960

Laura A. Standley
(State Engineer)

By

(Deputy)

GR-4071

#15.00