


Township 155 Range 44, W.M.

North

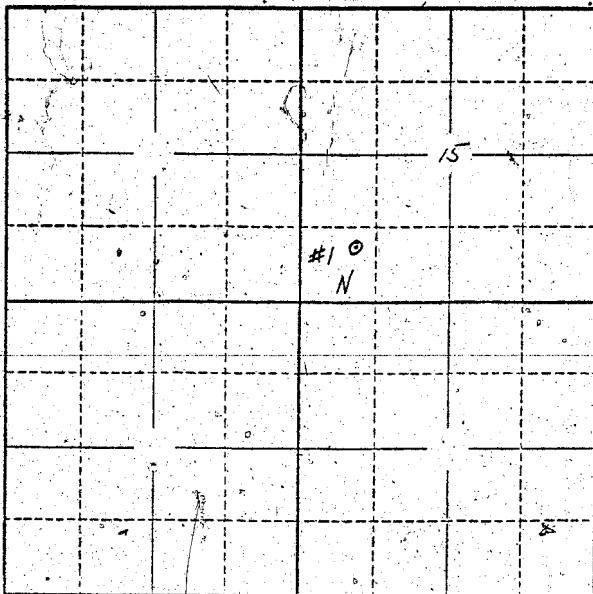

Locate well and acreage of irrigated land on plat.

Scale: 2" = 1 Mile

STATE OF OREGON

County of Linn

ss.

I, John B. McArthur, being first duly sworn, do hereby certify that I have read the foregoing Registration Statement and that all of the items therein contained are true to the best of my knowledge and belief.

John B. McArthur
by John B. McArthur
(Signature of Registrant)
His Attorney in Fact

Subscribed and sworn to before me this 15th day of July, 1958.

My commission expires May 27, 1962

Marion H. Wainwright
(Notary Public)

(SEAL)

CERTIFICATE OF REGISTRATION

STATE OF OREGON

County of Marion

ss.

This is to certify that the foregoing Registration Statement was received in the office of the State Engineer on the 15th day of August, 1958, at 8:00 o'clock A. M. and has been duly recorded in said office in Book No. 15 of Registration Statements on page GR 3586

Witness my hand this 15th day of September, 1959.

Laura A. Stanley
(State Engineer)

By

(Deputy)

GR 3586