


Township 9S Range 4W, W.M.

North

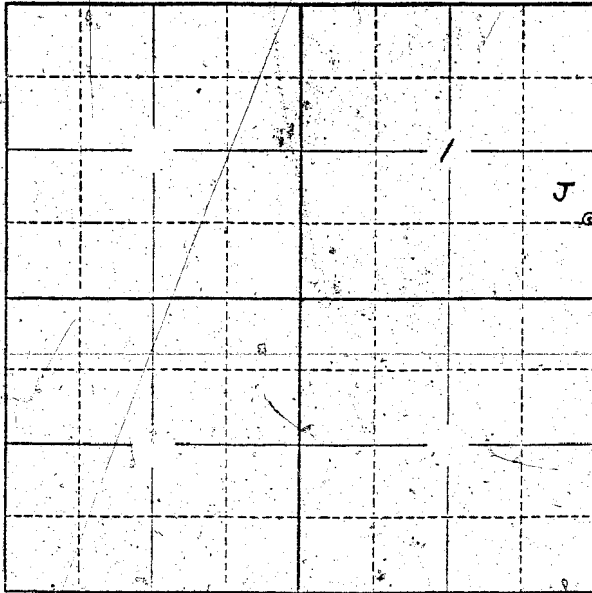

Locate well and acreage of irrigated land on plat.

Scale: 2" = 1 Mile

STATE OF OREGON

County of Marion } ss.

I, V. O. Weathers, being first duly sworn, do hereby certify that I have read the foregoing Registration Statement and that all of the items therein contained are true to the best of my knowledge and belief.

V. O. Weathers  
(Signature of Registrant)

Subscribed and sworn to before me this 4th day of August, 19 58

My commission expires My Commission Expires May. 25, 1959

Albert J. ...  
(Notary Public)

(SEAL)

**CERTIFICATE OF REGISTRATION**

STATE OF OREGON }  
County of Marion } ss.

This is to certify that the foregoing Registration Statement was received in the office of the State Engineer on the 4 day of August, 19 58, at 11:45 o'clock A.M. and has been duly recorded in said office in Book No. 15 of Registration Statements on page GR 3592.

Witness my hand this 15th day of September, 19 59.

Luvia A. Stanley  
(State Engineer)

By \_\_\_\_\_ (Deputy)

\$ 22-35

GR. 3592