


Township 1 S. Range 3 W. W.M.  
North

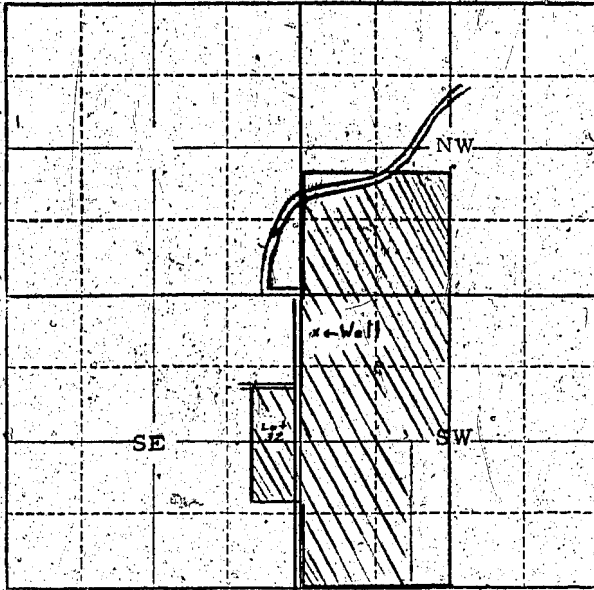

Property outlined in red belongs to petitioners.  
Shaded area indicates area to be irrigated

Locate well and acreage of irrigated land on plat.  
Scale: 2" = 1 Mile

STATE OF OREGON

County of Washington

SS.

I, Robert P. Nixon, of above named registrants, being first duly sworn, do hereby certify that I have read the foregoing Registration Statement and that all of the items therein contained are true to the best of my knowledge and belief.

*Robert P. Nixon*  
(Signature of Registrant)

Subscribed and sworn to before me this 24 day of August, 1955

My commission expires Dec. 3, 1956

*Edward P. Damp*  
(Notary Public)

(SEAL)

CERTIFICATE OF REGISTRATION

STATE OF OREGON

County of Marion

SS.

This is to certify that the foregoing Registration Statement was received in the office of the State Engineer on the 29th day of August, 1955, at 1:00 o'clock P.M. and has been duly recorded in said office in Book No. 1 of Registration Statements on page 3

Construction shall be completed by October 1, 1956, and the water completely applied to beneficial use by October 1, 1956

Witness my hand this 24th day of February, 1956

*Lewis A. Stanley*  
(State Engineer)

By \_\_\_\_\_  
(Deputy)