


Township: 65 Range 5W W.M. North

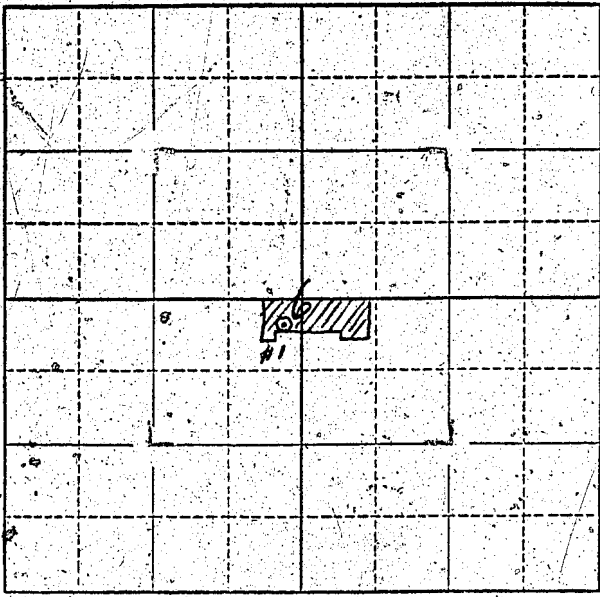

Locate well and acreage of irrigated land on plat.

Scale: 2" = 1 Mile

STATE OF OREGON

County of Marion

ss.

I, HUGH G. SHIELDS, being first duly sworn, do hereby certify that I have read the foregoing Registration Statement and that all of the items therein contained are true to the best of my knowledge and belief.

Hugh G. Shields
(Signature of Registrant)

Subscribed and sworn to before me this 15th day of November, 1955

My commission expires Sept. 8, 1956

Chas. L. Wheeler
(Notary Public)

(SEAL)

CERTIFICATE OF REGISTRATION

STATE OF OREGON

County of Marion

ss.

For Certificate of Registration see Page GR-35 G

This is to certify that the foregoing Registration Statement was received in the office of the State Engineer on the 15th day of November, 1955, at 2:00 o'clock P.M. and has been duly recorded in said office in Book No. 1 of Registration Statements on page

Construction shall be completed by 1955, and the water completely applied to beneficial use by 1955.

Witness my hand this day of 1955

Lewis A. Stanley
(State Engineer)

By (Deputy)