


Township 6N Range 35E, W.M.
North

Well location → D
~~522~~ 522 feet S
+ 30' E of NW
Corner of Sec.

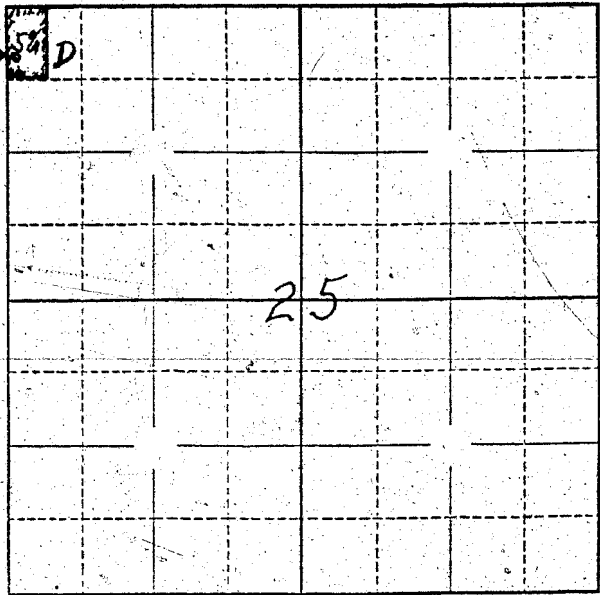

Locate well and acreage of irrigated land on plat.

Scale: $\frac{1}{4}$ " = 1 Mile

STATE OF OREGON


I, Clayton & Emma Cleaslin, being first duly sworn, do hereby certify that I have read the foregoing Registration Statement and that all of the items therein contained are true to the best of my knowledge and belief.

Emma Cleaslin
(Signature of Registrant)

Subscribed and sworn to before me this 31st day of July, 1958

My commission expires Aug 5, 1962 J. N. [Signature]
(Notary Public)

(SEAL)

CERTIFICATE OF REGISTRATION

STATE OF OREGON } ss.
County of Marion

This is to certify that the foregoing Registration Statement was received in the office of the State Engineer on the 4th day of August, 1958, at 2.00 o'clock A.M. and has been duly recorded in said office in Book No. 15 of Registration Statements on page GR 3610

Witness my hand this 15th day of September, 1959

Lewis A. Stanley
(State Engineer)

By _____
(Deputy)

#15.00