


SW 1/4 Section 34

Township 6N Range 35E, W.M.

W 1/4

North

34

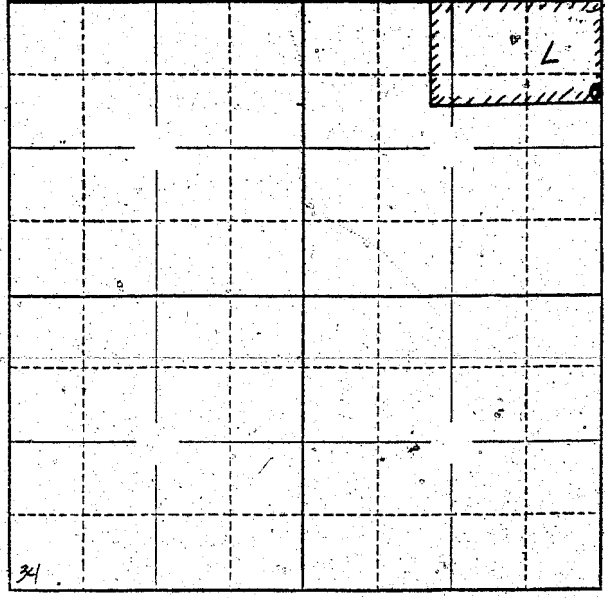

Location of well
 450.2' S 4' W
 NE CORNER
 SW 1/4 Sec 34
 TWP 6N R. 35E

Locate well and acreage of irrigated land on plat.

Scale: 1" = 1/2 Mile

STATE OF OREGON

County of Umatilla } ss.

I, Mrs. Eddie Le Fore, being first duly sworn, do hereby certify that I have read the foregoing Registration Statement and that all of the items therein contained are true to the best of my knowledge and belief.

Mrs. Eddie Le Fore
 (Signature of Registrant)

Subscribed and sworn to before me this 1st day of August, 1958.

My commission expires October 6, 1960

J. R. Dade
 (Notary Public for Oregon)

(SEAL)

CERTIFICATE OF REGISTRATION

STATE OF OREGON

County of Marion } ss.

This is to certify that the foregoing Registration Statement was received in the office of the State Engineer on the 4th day of August, 1958, at 2:00 o'clock A.M. and has been duly recorded in said office in Book No. 15 of Registration Statements on page GR- 3611

Witness my hand this 15th day of September, 1959.

Lewis A. Stanley
 (State Engineer)

By _____ (Deputy)

\$15.00