


Township 6N Range 35E, W.M.
North

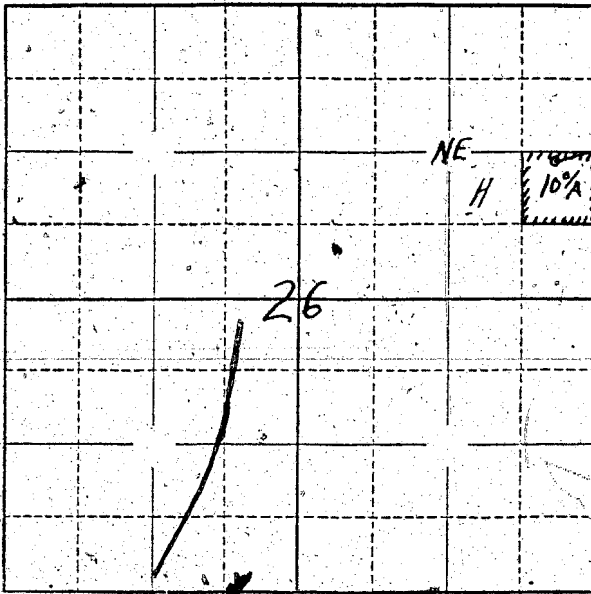

Well location
35 feet west &
94 feet south of
NE corner of NE
of SE 4 of NE of
Sec 26

Locate well and acreage of irrigated land on plat.
Scale: $\frac{2}{4}$ = 1 Mile

STATE OF OREGON }
County of Marion } ss.

I, Lewis A. Stanley, being first duly sworn, do hereby certify that I have read the foregoing Registration Statement and that all of the items therein contained are true to the best of my knowledge and belief.

X
(Signature of Registrant)

Subscribed and sworn to before me this 15 day of September, 1959.

My commission expires _____ (Notary Public)

(SEAL)

CERTIFICATE OF REGISTRATION

STATE OF OREGON }
County of Marion } ss.

This is to certify that the foregoing Registration Statement was received in the office of the State Engineer on the 15th day of August, 1958, at 2:00 o'clock A.M. and has been duly recorded in said office in Book No. 15 of Registration Statements on page GR 3612

Witness my hand this 15th day of September, 1959.

Lewis A. Stanley
(State Engineer)

By _____ (Deputy)

\$15.00