

Sec. 6

Township 10 Range 2 W., W.M.


NW $\frac{1}{4}$

North

600' South
of N line

+
1000' East
of W. line.

Located in
E $\frac{1}{2}$ of the
NW $\frac{1}{4}$ of
Sec. 6 - 10-2W

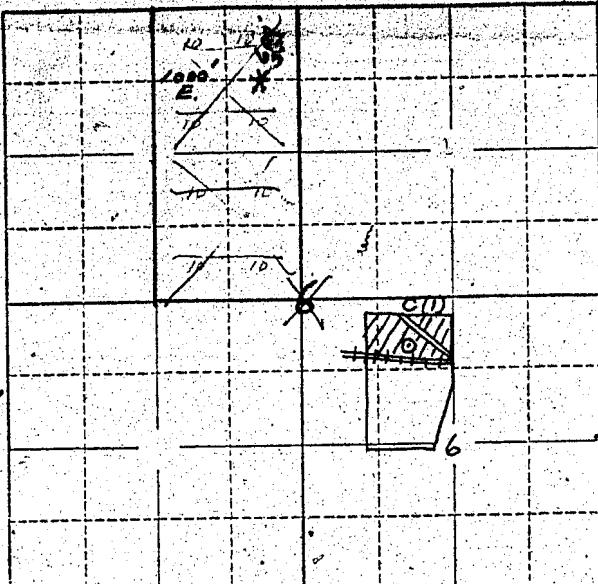

Locate well and acreage of irrigated land on plat.

Scale: 1" = 1 Mile

4

STATE OF OREGON

County of Marion

{ ss.

I, B. A. Fall, being first duly sworn, do hereby certify that I have read the foregoing Registration Statement and that all of the items therein contained are true to the best of my knowledge and belief.

B. A. Fall
(Signature of Registrant)

Subscribed and sworn to before me this 8th day of March, 1957.

My commission expires MY COMMISSION EXPIRES JULY 25, 1960

Glenys A. Shields
(Notary Public)

(SEAL)

CERTIFICATE OF REGISTRATION

STATE OF OREGON

{ ss.

County of Marion

This is to certify that the foregoing Registration Statement was received in the office of the State Engineer on the 18th day of March, 1957, at 8:00 o'clock A.M. and has been duly recorded in said office in Book No. 3 of Registration Statements on page GR-104 C.

~~Construction shall be completed by X-X-X-X-X-X-X-X-X and the water completely applied to the beneficial use by X-X-X-X-X-X-X-X-X~~

Witness my hand this 26th day of June, 1957.
Lewis A. Stanley
(State Engineer)

#1592

By

(Deputy)

132

404 C