


Township 10S Range 3W W.M.

North

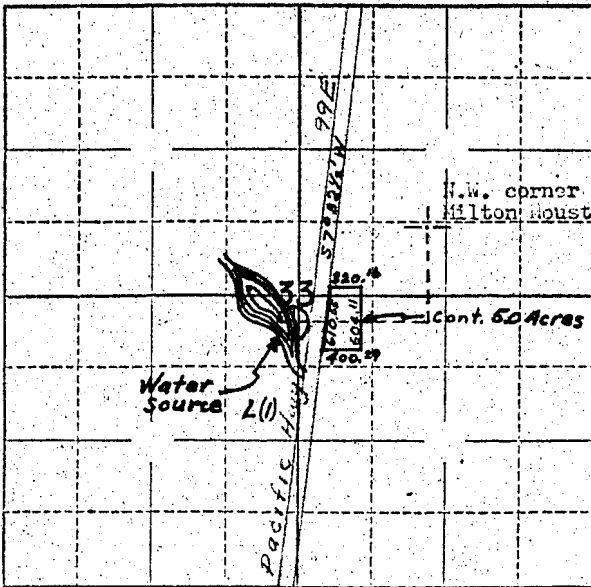

NOTE: Water source is located at a point which is referenced to N.W. corner D.L.C. #43 as follows: Bearing S 1° 56' E 90' from said corner; the S 89° 50' W 1185.0' to approximate location of pump.

Locate well and acreage of irrigated land on plat.

Scale: 1" = 1 Mile

4"

STATE OF OREGON

County of CLATSOP } ss.

I, George Settlement, being first duly sworn, do hereby certify that I have read the foregoing Registration Statement and that all of the items therein contained are true to the best of my knowledge and belief.

George Settlement

Harriet Settlement

(Signature of Registrant)

Subscribed and sworn to before me this 15 day of MARCH, 1957

My commission expires JULY 24, 1960

Marvin W. Deal

(Notary Public)

(SEAL)

### CERTIFICATE OF REGISTRATION

STATE OF OREGON } ss.  
County of Marion

This is to certify that the foregoing Registration Statement was received in the office of the State Engineer on the 19th day of March, 1957, at 8:00 o'clock A. M. and has been duly recorded in said office in Book No. 3 of Registration Statements on page GR-385 C.

~~Construction shall be completed by X-X-X-X-X-X-X-X-X-X-X-X-X-X-X-X-X-X and the water completely applied to X-X-X-X-X-X-X-X-X-X-X-X-X-X-X-X-X-X and beneficial use by X-X-X-X-X-X-X-X-X-X-X-X-X-X-X-X-X-X~~

Witness my hand this 23rd day of May, 1957

Lewis A. Stanley

(State Engineer)

By \_\_\_\_\_ (Deputy)