


Township 17S, Range 3W, W.M.
North

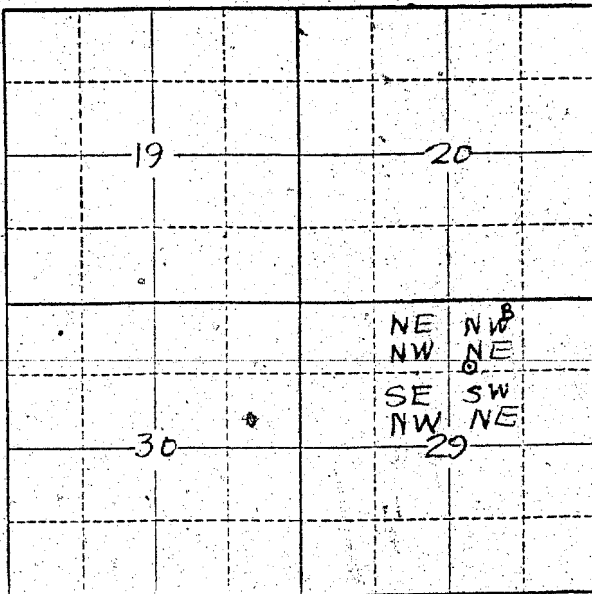

SEE LARGE MAP

Locate well and acreage of irrigated land on plat.
Scale: 2" = 1 Mile

STATE OF OREGON

County of Lane } ss.

I, Lillie Hayes McKay, being first duly sworn, do hereby certify that I have read the foregoing Registration Statement and that all of the items therein contained are true to the best of my knowledge and belief.

Lillie Hayes McKay
(Signature of Registrant)

Subscribed and sworn to before me this 1st day of August, 1958.

My commission expires CHARLES W. ROFFE

Charles W. Roffe
(Notary Public)

My Commission Expires June 24, 1961

(SEAL)

CERTIFICATE OF REGISTRATION

STATE OF OREGON

County of Marion } ss.

This is to certify that the foregoing Registration Statement was received in the office of the State Engineer on the 4th day of August, 1958, at 2:00 o'clock A.M. and has been duly recorded in said office in Book No. 15 of Registration Statements on page 52-3623

Witness my hand this 15th day of September, 1959

Lewis A. Stanley
(State Engineer)

By _____ (Deputy)

\$ 15.00