


Township 15S Range 4W W.M.
North

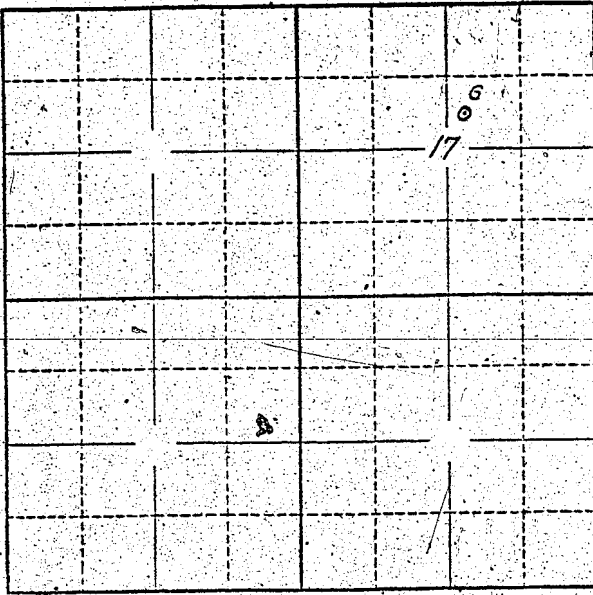

Locate well and acreage of irrigated land, on plat.
Scale: 2" = 1 Mile

STATE OF OREGON

County of Linn

ss.

I, Max Nielsen, being first duly sworn, do hereby certify that I have read the foregoing Registration Statement and that all of the items therein contained are true to the best of my knowledge and belief.

Max Nielsen

(Signature of Registrant)

Subscribed and sworn to before me this 30th day of July, 1958

My commission expires Sept. 25th., 1959

Jerry

(Notary Public)

(SEAL)

CERTIFICATE OF REGISTRATION

STATE OF OREGON

County of Marion

ss.

This is to certify that the foregoing Registration Statement was received in the office of the State Engineer on the 7 day of August, 1958, at 8:00 o'clock A. M. and has been duly recorded in said office in Book No. 15 of Registration Statements on page GR-3635

Witness my hand this 15th day of September, 1959

Lewis A. Stanley

(State Engineer)

By

(Deputy)

\$15.00