


T. 98.10S. R. 3W. W.M.

137
BR
J13

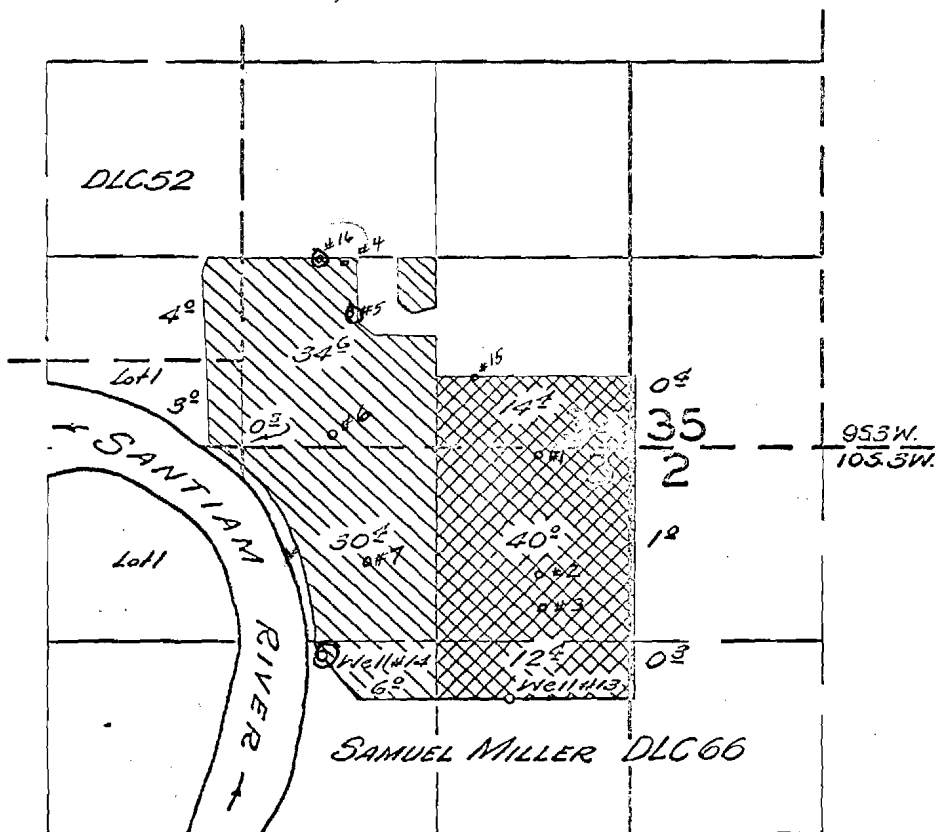

FINAL PROOF SURVEY
UNDER

Application No. G-1693 Permit No. G-1553
G-1694 G-1554
IN NAME OF



.....DALE L. TURNIDGE.....

Surveyed April 7, 1961, by C. G. Sautter

