


North

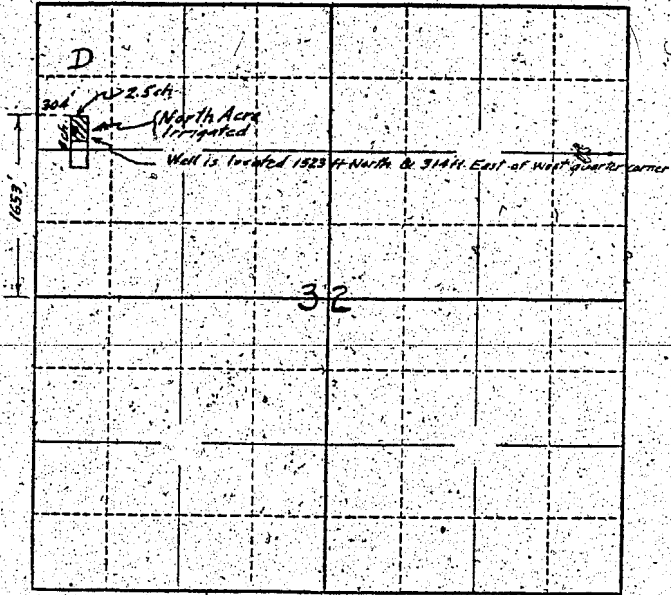

Locate well and acreage of irrigated land on plat.

Scale: 1" = 1 Mile

STATE OF OREGON

County of _____ ss.

I, William C. Miller being first duly sworn, do hereby certify that I have read the foregoing Registration Statement and that all of the items therein contained are true to the best of my knowledge and belief.

William C. Miller
(Signature of Registrant)

Subscribed and sworn to before me this 31st day of July, 1959

My commission expires _____
(Notary Public)

(SEAL)

CERTIFICATE OF REGISTRATION

STATE OF OREGON }
County of Marion } ss.

This is to certify that the foregoing Registration Statement was received in the office of the State Engineer on the 4th day of August, 1958 at 2:00 o'clock A.M. and has been duly recorded in said office in Book No. 15 of Registration Statements on page GR-3641

Witness my hand this 15th day of September, 1959

Harold A. Stanley
(State Engineer)

By _____
(Deputy)

\$15.00