

North

27 26

33 34

#9 NO1

33 34 3 2

Locate well and acreage of irrigated land on plat.

Locate well and acreage of irrigated land on plat.

Scale: 4" = 1 Mile

County of \_\_\_\_\_

SS:

I, \_\_\_\_\_, being first duly sworn, do hereby certify that I have read the foregoing Registration Statement and that all of the items therein contained are true to the best of my knowledge and belief.

(Signature of Registrant)

Subscribed and sworn to before me this \_\_\_\_\_ day of \_\_\_\_\_, 19\_\_\_\_

**My commission expires**

(Notary Public)

(SEAL)

See Page GR-388 0 for  
**CERTIFICATE OF REGISTRATION**

STATE OF OREGON

County of Marion

59


~~Construction shall be completed by x-x-x-x-x-x-x-x-10-x-x-and-the-water-completely-applied-to-~~

Witness my hand this ..... day of ....., 19.....


(State Engineer)

By

(Deputy)

- 388C

Township 95 Range 34 W.M.

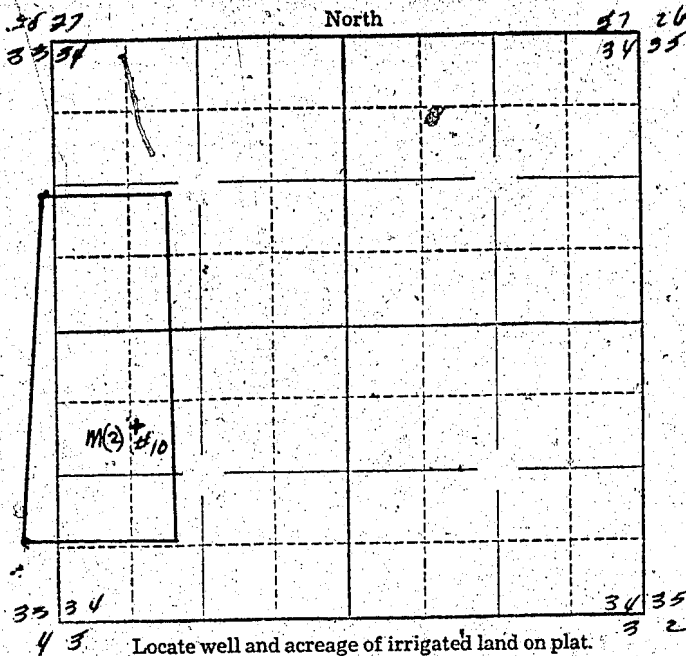

Locate well and acreage of irrigated land on plat.

Scale: 4' = 1 Mile

STATE OF OREGON

County of \_\_\_\_\_

ss.

I, \_\_\_\_\_, being first duly sworn, do hereby certify that I have read the foregoing Registration Statement and that all of the items therein contained are true to the best of my knowledge and belief.

(Signature of Registrant)

Subscribed and sworn to before me this \_\_\_\_\_ day of \_\_\_\_\_, 19\_\_\_\_.

My commission expires \_\_\_\_\_

(Notary Public)

(SEAL)

See Page GR-388 O for  
**CERTIFICATE OF REGISTRATION**

STATE OF OREGON

County of Marion

ss.

~~This is to certify that the foregoing Registration Statement was received in the office of the State Engineer on the \_\_\_\_\_ day of \_\_\_\_\_, 19\_\_\_\_, at \_\_\_\_\_, Oregon, and has been duly recorded in said office in Book No. \_\_\_\_\_ of Registration Statements on page \_\_\_\_\_.~~  
~~Construction shall be completed by \_\_\_\_\_, 19\_\_\_\_, and the water completely applied to beneficial use by \_\_\_\_\_, 19\_\_\_\_.~~


Witness my hand this \_\_\_\_\_ day of \_\_\_\_\_, 19\_\_\_\_.

(State Engineer)

By \_\_\_\_\_

(Deputy)

R - 388 G

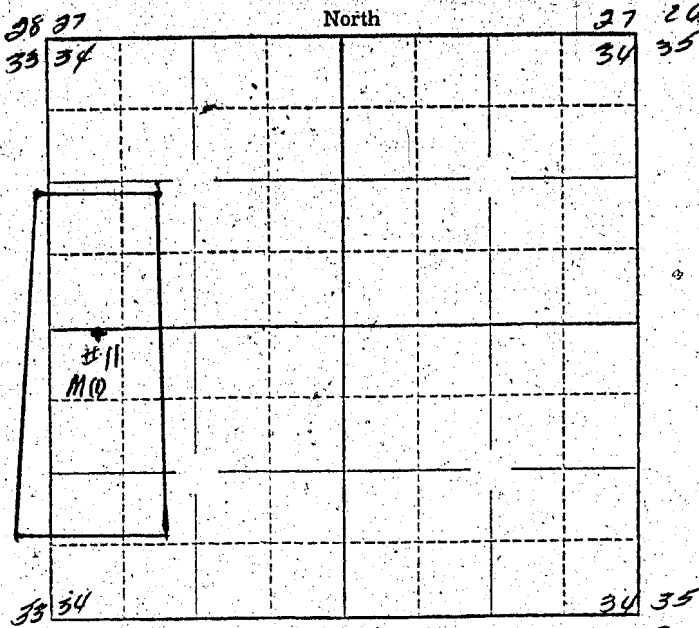

Locate well and acreage of irrigated land on plat. 3 2  
 Scale: 4' = 1 Mile

STATE OF OREGON }  
 County of \_\_\_\_\_ } ss.

I, \_\_\_\_\_, being first duly sworn, do hereby certify that I have read the foregoing Registration Statement and that all of the items therein contained are true to the best of my knowledge and belief.

\_\_\_\_\_  
 (Signature of Registrant)

Subscribed and sworn to before me this \_\_\_\_\_ day of \_\_\_\_\_, 19\_\_\_\_

My commission expires \_\_\_\_\_  
 (Notary Public)

(SEAL)

See Page GR-388 O for  
**CERTIFICATE OF REGISTRATION**

STATE OF OREGON }  
 County of Marion } ss.

~~This is to certify that the foregoing Registration Statement was received in the office of the State Engineer on the -X-X-X-X- day of -X-X-X-X-X-X-X-X-X-X-, 19-X-X-, at -X-X-X-X-X-X-X-X-X-X- and has been duly recorded in said office in Book No. -X-X-X-X-X-X- of Registration Statements on page -X-X-X-X-X-X-.~~  
~~Construction shall be completed by -X-X-X-X-X-X-X-X-X-X-, 19-X-X-, and the water completely applied to beneficial use by -X-X-X-X-X-X-X-X-X-X-, 19-X-X-X-.~~

Witness my hand this \_\_\_\_\_ day of \_\_\_\_\_, 19\_\_\_\_

\_\_\_\_\_  
 (State Engineer)

By \_\_\_\_\_  
 (Deputy)

Township 9 S Range 3 W W.M.

28 27 North 27 26  
53 54 54 35

E(1)  
#12

33 34 34 35  
43

Locate well and acreage of irrigated land on plat. 3 2

Locate well and acreage of irrigated land on plat.

Scale:  $\frac{1}{4}$ " = 1 Mile

County of Marion ss.

I, Dale L. Turnidge, being first duly sworn, do hereby certify that I have read the foregoing Registration Statement and that all of the items therein contained are true to the best of my knowledge and belief.

*Sal. H. V. Purridge*  
(Signature of Registrant)

(Signature of Registrant)

Subscribed and sworn to before me this 20 day of March, 1957

My commission expires September 8, 1960

*MacKeggie*  
(Notary Public)

(Notary Public)

(SEAL)

## CERTIFICATE OF REGISTRATION

County of Marion

This is to certify that the foregoing Registration Statement was received in the office of the State Engineer on the 20th day of March, 1957, at 2:30 o'clock P.M. and has been duly recorded in said office in Book No. 3 of Registration Statements on page GR-388.0

~~Construction shall be completed by x-x-x-x-x-x-x-x-x-x-12-x-x and the water complaint applied to x-~~


Witness my hand this 23rd day of May, 19 57.

19 57  
Lewis G. Stanley  
(State Engineer)

(State Engineer)

By

(Deputy)

GR - 3886