


Township 11 S Range 12 E, W.M.

Sec. 16 North Sec. 15

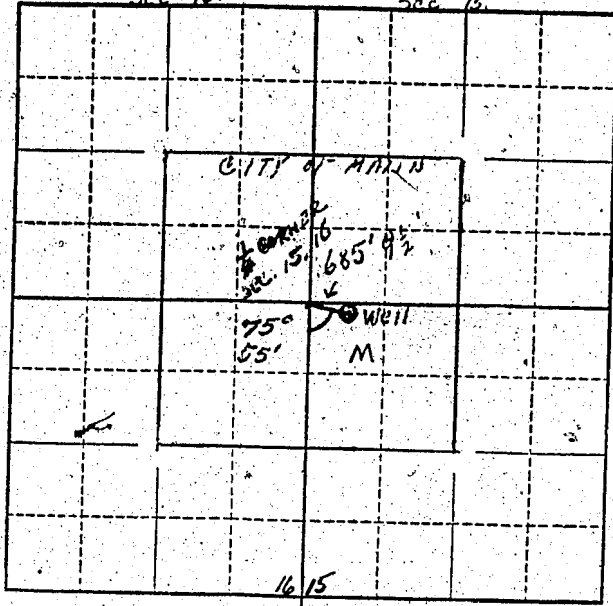

Locate well and acreage of irrigated land on plat.

Scale: 2" = 1 Mile

STATE OF OREGON

County of Klamath

ss.

Recorder for Malin, Oregon

I, Ival C. Taylor, the City, being first duly sworn, do hereby certify that I have read the foregoing Registration Statement and that all of the items therein contained are true to the best of my knowledge and belief.

Ival C. Taylor
(Signature of Registrant)

Subscribed and sworn to before me this 29th day of July, 1958

My commission expires Aug. 3, 1958

Herbert E. Taylor
(Notary Public)

(SEAL)

CERTIFICATE OF REGISTRATION

STATE OF OREGON

County of Marion

ss.

This is to certify that the foregoing Registration Statement was received in the office of the State Engineer on the 4th day of August, 1958, at 2:00 o'clock A. M. and has been duly recorded in said office in Book No. 12 of Registration Statements on page GR-2895

Witness my hand this 25th day of May, 1959

Lucretia J. Stanley
(State Engineer)

By

(Deputy)

\$ 20.00

GR - 2895