


North

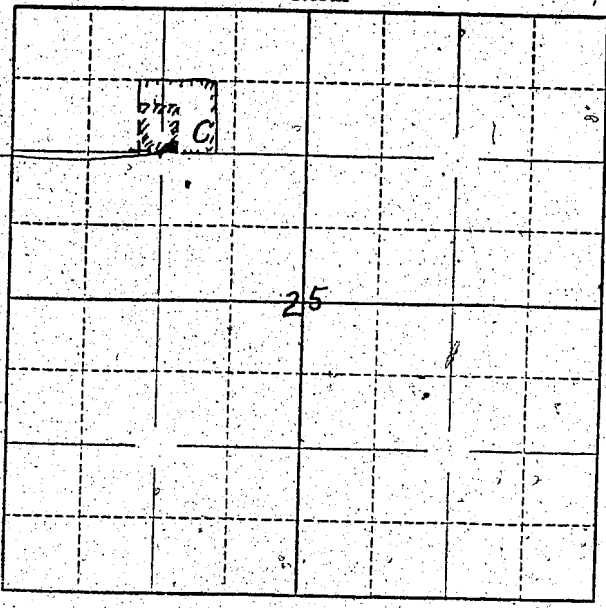

Well location
 280 feet East
 of SW Corner
 NE 1/4 NW 1/4 of
 Sec 25

Locate well and acreage of irrigated land on plat.

Scale: ~~1~~ ⁴ - 1 Mile

STATE OF OREGON

County of Umatilla } ss.

I, Tom Hobbs, being first duly sworn, do hereby certify that I have read the foregoing Registration Statement and that all of the items therein contained are true to the best of my knowledge and belief.

[Signature]
 (Signature of Registrant)

Subscribed and sworn to before me this 16th day of March, 1953

My commission expires September
 (Notary Public)

(SEAL)

CERTIFICATE OF REGISTRATION

STATE OF OREGON }
 County of Marion } ss.

This is to certify that the foregoing Registration Statement was received in the office of the State Engineer on the 4th day of August, 1958, at 8:00 o'clock A. M. and has been duly recorded in said office in Book No. 16 of Registration Statements on page GR-3862

Witness my hand this 28th day of December, 1959

[Signature: Lewis A. Stanley]
 (State Engineer)

By _____ (Deputy)

\$15.00