


North

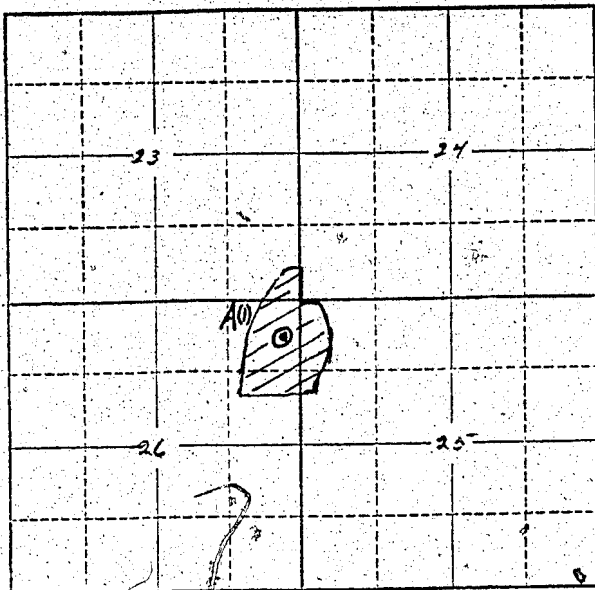

Locate well and acreage of irrigated land on plat.

Scale: 2" = 1 Mile

STATE OF OREGON


ss.

CLARK NOBLE

I, CLARK NOBLE, being first duly sworn, do hereby certify that I have read the foregoing Registration Statement and that all of the items therein contained are true to the best of my knowledge and belief.

Clark Noble

(Signature of Registrant)

Subscribed and sworn to before me this 30 day of March, 19 57

My commission expires Sept 18 1959

Virginia M. Galbreath

(Notary Public)

(SEAL)

CERTIFICATE OF REGISTRATION

STATE OF OREGON

County of Marion

ss.

This is to certify that the foregoing Registration Statement was received in the office of the State Engineer on the 20th day of March, 19 57, at 10:30 o'clock A. M. and has been duly recorded in said office in Book No. 3 of Registration Statements on page GR-390 C

~~Construction shall be completed by X-X-X-X-X-X-X-X-X-X and the water completely applied to beneficial uses by X-X-X-X-X-X-X-X-X-X~~

Witness my hand this 23rd day of May, 19 57

Lewis A. Stanley

(State Engineer)

By

(Deputy)

\$18.75