


SW 1/4 Sec 35

Township 6N Range 35E, W.M.

North

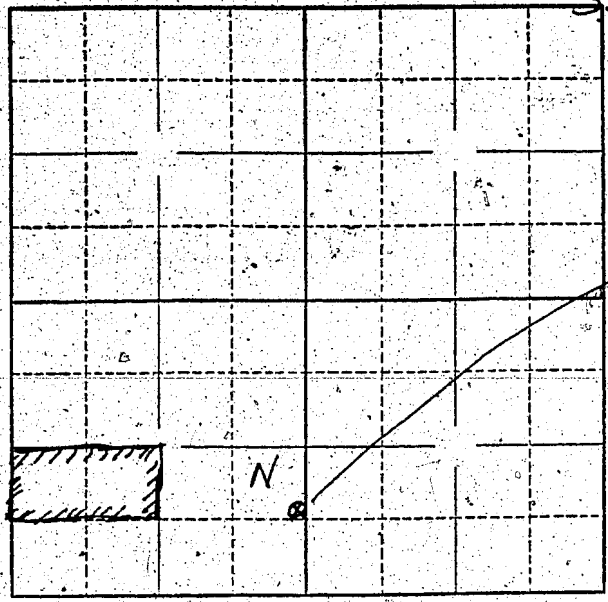

Well  
 location  
 980' S 20' W.  
 of NE corner  
 SW 1/4 SW 1/4  
 Sec 35 T 6 N  
 R. 35 E

Locate well and acreage of irrigated land on plat.

Scale: 2" = 1 Mile

STATE OF OREGON

County of Marion } ss.

I, Mrs Robert Pears, being first duly sworn, do hereby certify that I have read the foregoing Registration Statement and that all of the items therein contained are true to the best of my knowledge and belief.

Mrs Robert Pears  
 (Signature of Registrant)

Subscribed and sworn to before me this 21 day of August, 1958

My commission expires Jan-26, 1962 by G. B. Bishop  
 (Notary Public)

(SEAL)

**CERTIFICATE OF REGISTRATION**

STATE OF OREGON

County of Marion } ss.

This is to certify that the foregoing Registration Statement was received in the office of the State Engineer on the 4<sup>th</sup> day of August, 1958, at 4:00 o'clock P. M. and has been duly recorded in said office in Book No. 15 of Registration Statements on page 3672

Witness my hand this 20<sup>th</sup> day of October, 1959

Stewart A. Stanley  
 (State Engineer)

By \_\_\_\_\_ (Deputy)

#15.00