


North

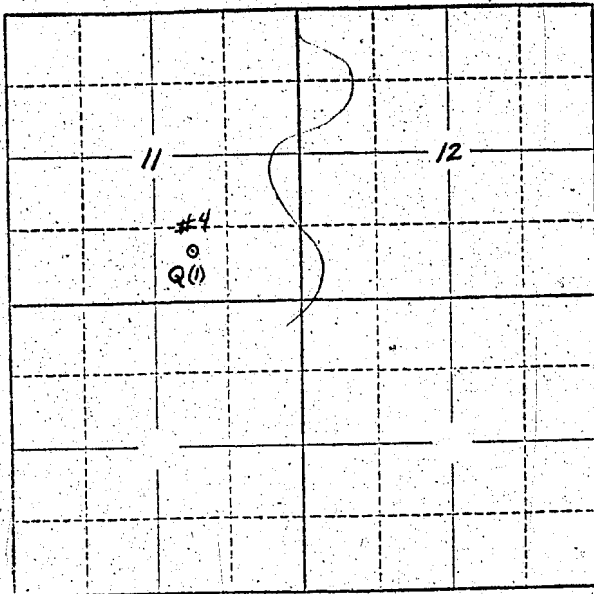

Locate well and acreage of irrigated land on plat.

Scale: 2" = 1 Mile

STATE OF OREGON

County of .....

} ss.

I, \_\_\_\_\_, being first duly sworn, do hereby certify that I have read the foregoing Registration Statement and that all of the items therein contained are true to the best of my knowledge and belief.

.....  
(Signature of Registrant)

Subscribed and sworn to before me this ..... day of ....., 19.....

My commission expires .....

.....  
(Notary Public)

(SEAL)

See Page GR-391 O for  
**CERTIFICATE OF REGISTRATION**

STATE OF OREGON

County of Marion

} ss.

~~This is to certify that the foregoing Registration Statement was received in the office of the State Engineer on the -X-X-X- day of -X-X-X-X-X-X-X-X- 19-X-X- at -X-X-X-X-X- o'clock -X-X- AM and has been duly recorded in said office in Book No. -X-X-X-X-X- of Registration Statements on page -X-X-X-X-X-.~~

~~Construction shall be completed by -X-X-X-X-X-X-X-X- 19-X-X- and the water completely applied to beneficial use by -X-X-X-X-X-X-X-X- 19-X-X-.~~


Witness my hand this ..... day of ....., 19.....

.....  
(State Engineer)

By .....

.....  
(Deputy)



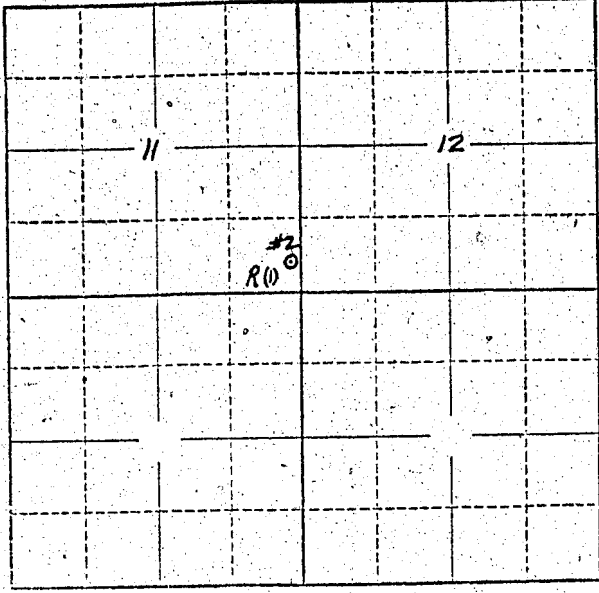

Locate well and acreage of irrigated land on plat.  
Scale: 2" = 1 Mile

STATE OF OREGON }  
County of ..... } ss.

I, ..... being first duly sworn, do hereby certify that I have read the foregoing Registration Statement and that all of the items therein contained are true to the best of my knowledge and belief.

.....  
(Signature of Registrant)

Subscribed and sworn to before me this ..... day of ....., 19.....

My commission expires ..... (Notary Public)

(SEAL)

See Page GR-391 O for  
**CERTIFICATE OF REGISTRATION**

STATE OF OREGON }  
County of Marion } ss.

~~This is to certify that the foregoing Registration Statement was received in the office of the State Engineer on the X-X-X day of X-X-X-X-X-X-X-X, 19-X-X at X-X-X-X-X-X-X-X and has been duly recorded in said office in Book No. X-X-X-X-X-X of Registration Statements on page X-X-X-X-X-X.~~

~~Construction shall be completed by X-X-X-X-X-X-X-X, 19X-X, and the water completely applied to beneficial use by X-X-X-X-X-X-X-X, 19X-X.~~ X X

Witness my hand this ..... day of ....., 19.....

.....  
(State Engineer)

By .....  
(Deputy)

