


Township 17S Range 3W W.M.

North

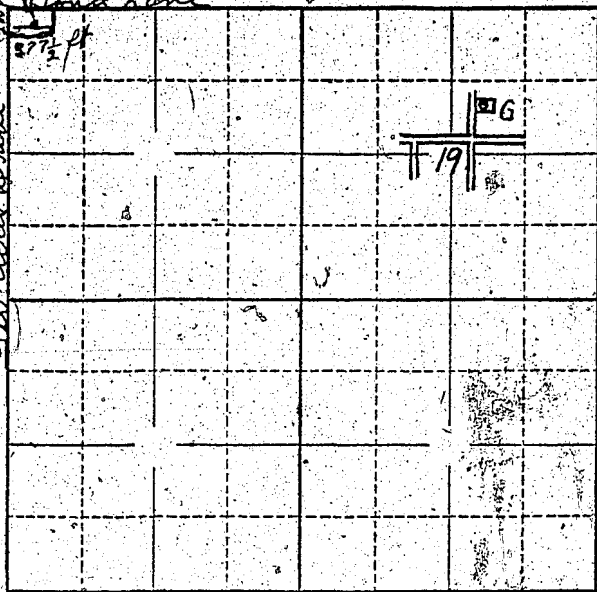

Locate well and acreage of irrigated land on plat.

Scale: 2" = 1 Mile

STATE OF OREGON

County of Lane } ss.

I, Louis Pope, being first duly sworn, do hereby certify that I have read the foregoing Registration Statement and that all of the items therein contained are true to the best of my knowledge and belief.

Mrs. Louis Pope
(Signature of Registrant)

Subscribed and sworn to before me this 2 day of August, 1958

My commission expires Oct-29-1960 Marvin L. ...
(Notary Public)

(SEAL)

CERTIFICATE OF REGISTRATION

STATE OF OREGON

County of Marion } ss.

This is to certify that the foregoing Registration Statement was received in the office of the State Engineer on the 4 day of August, 1958, at 8:00 o'clock A. M. and has been duly recorded in said office in Book No. 17 of Registration Statements on page GR-4059

Witness my hand this 16th day of May, 1960

Laura A. Stanley
(State Engineer)

By _____ (Deputy)

GR 4059

#15.00