


North

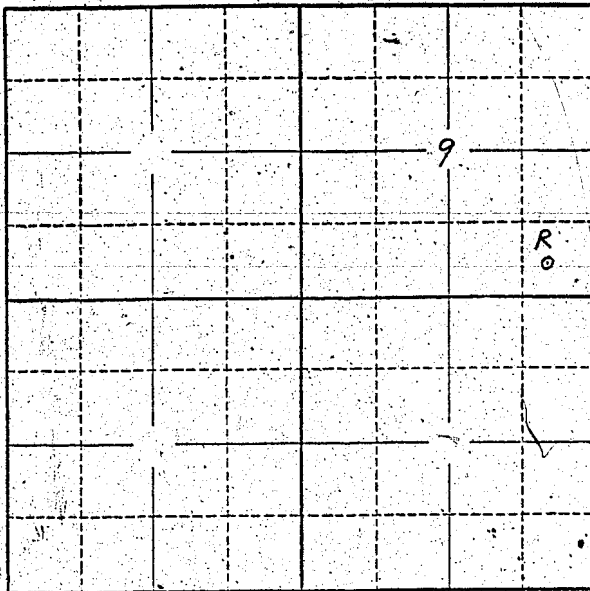

Locate well and acreage of irrigated land on plat

Scale: 2" = 1 Mile

STATE OF OREGON

County of Josephine ss.

I, Raymond L. Frost and Loretta R. Frost being first duly sworn, do hereby certify that I have read the foregoing Registration Statement and that all of the items therein contained are true to the best of my knowledge and belief.

Raymond L. Frost  
(Signature of Registrant)

Subscribed and sworn to before me this 31st day of July, 1958

My commission expires Dec. 18th '60 Stella M. Stengel  
(Notary Public)

(SEAL)

CERTIFICATE OF REGISTRATION

STATE OF OREGON }  
County of Marion } ss.

This is to certify that the foregoing Registration Statement was received in the office of the State Engineer on the 1st day of August, 1958, at 1.00 o'clock PM and has been duly recorded in said office in Book No. 16 of Registration Statements on page GR-3860

Witness my hand this 28th day of December, 1959

Laura A. Stanley  
(State Engineer)

By \_\_\_\_\_ (Deputy)

\$18.60