


North

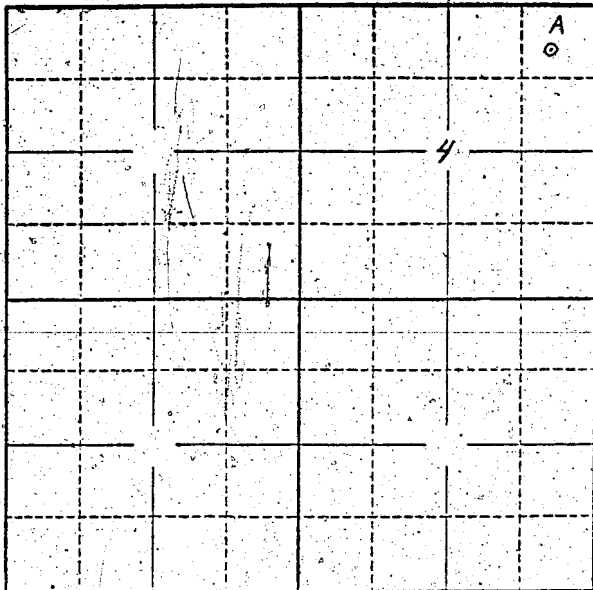

Locate well and acreage of irrigated land on plat.

Scale: 2" = 1 Mile

STATE OF OREGON

County of Linn } ss.

I, Cleo Hink Horse being first duly sworn, do hereby certify that I have read the foregoing Registration Statement and that all of the items therein contained are true to the best of my knowledge and belief.

Cleo Hink Horse
(Signature of Registrant)

Subscribed and sworn to before me this 1 day of August, 1958

My commission expires MY COMMISSION EXPIRES MAY 22, 1962 Richard E. Phillips
(Notary Public)

(SEAL)

CERTIFICATE OF REGISTRATION

STATE OF OREGON }
County of Marion } ss.

This is to certify that the foregoing Registration Statement was received in the office of the State Engineer on the 4th day of August, 1958, at 6:00 o'clock A. M. and has been duly recorded in said office in Book No. 15 of Registration Statements on page GR-3592

Witness my hand this 20th day of October, 1959

Lawrence A. Stanley
(State Engineer)

By _____ (Deputy)

\$15.00