


North

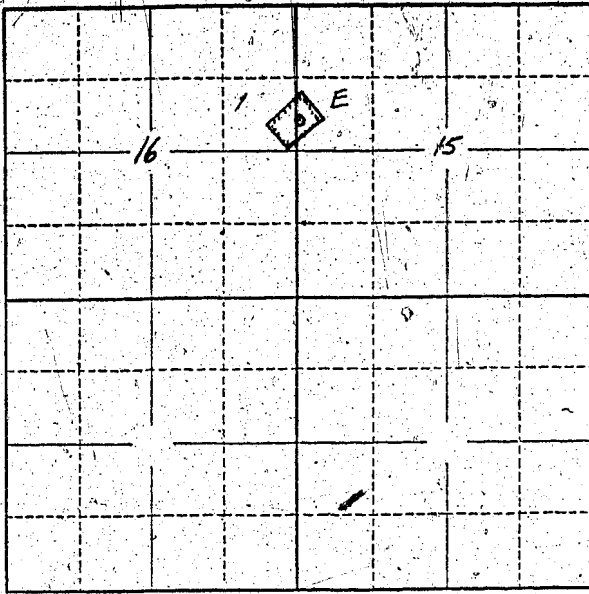

Locate well and acreage of irrigated land on plat.

Scale: 2" = 1 Mile

STATE OF OREGON

County of Cuhy

ss.

I, E. L. Rigdon, being first duly sworn, do hereby certify that I have read the foregoing Registration Statement and that all of the items therein contained are true to the best of my knowledge and belief.

*E. L. Rigdon*  
(Signature of Registrant)

Subscribed and sworn to before me this 31 day of July, 1958.

My Commission Expires July 2, 1962

My commission expires

*R. E. Anderson*  
(Notary Public)

(SEAL)

**CERTIFICATE OF REGISTRATION**

STATE OF OREGON

County of Marion

ss.

This is to certify that the foregoing Registration Statement was received in the office of the State Engineer on the 4 day of August, 1958, at 8:00 o'clock A.M. and has been duly recorded in said office in Book No. 16 of Registration Statements on page GR-3931

Witness my hand this 15<sup>th</sup> day of February, 1960

*Laura A. Stanley*  
(State Engineer)

By \_\_\_\_\_ (Deputy)

\$15.00