


North

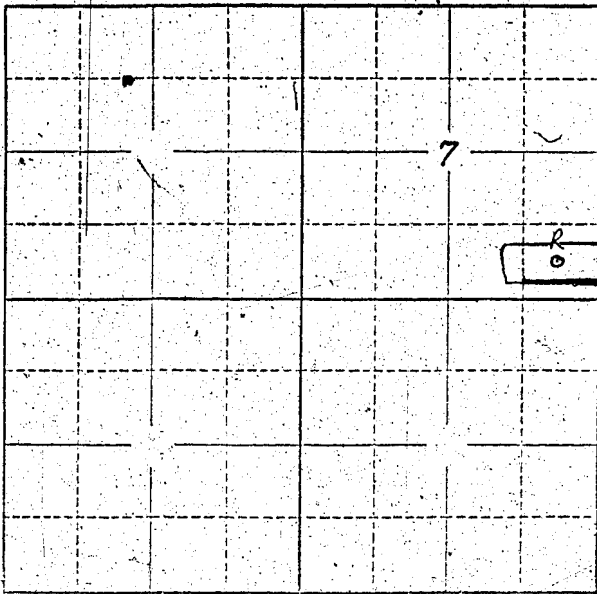

Locate well and acreage of irrigated land on plat.

Scale: 2" = 1 Mile

STATE OF OREGON

County of Benton } ss.

I, Elliott M Butler, being first duly sworn, do hereby certify that I have read the foregoing Registration Statement and that all of the items therein contained are true to the best of my knowledge and belief.

Elliott M Butler  
(Signature of Registrant)

Subscribed and sworn to before me this 15th day of July, 1958.

My commission expires 2-18-61 Rec E. Sam H.  
(Notary Public)

(SEAL)

**CERTIFICATE OF REGISTRATION**

STATE OF OREGON

County of Marion } ss.

This is to certify that the foregoing Registration Statement was received in the office of the State Engineer on the 14th day of August, 1958, at 11:00 o'clock A.M. and has been duly recorded in said office in Book No. 16 of Registration Statements on page GR-4030

~~xx Construction shall be completed by xxxxxxxxxxxxxxxxxx and the water completely applied to beneficial use by xxxxxxxxxxxxxxxxxx 19xx xx~~

Witness my hand this 11th day of April, 1960.

Lawrence A. [Signature]  
(State Engineer)

#15.15

By \_\_\_\_\_ (Deputy)  
GR-4030