



RECEIVED
STATE ENGINEER
SALEM, OREGON

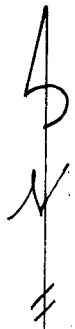

31 33

6 5

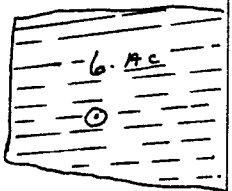

GR 4115

NE 1/4 of N.W. 1/4

990'± S

±

3120' W

N.E. cor. sec. 6

T-16-S

R-4-W

Scale: 1" = 660'