


North

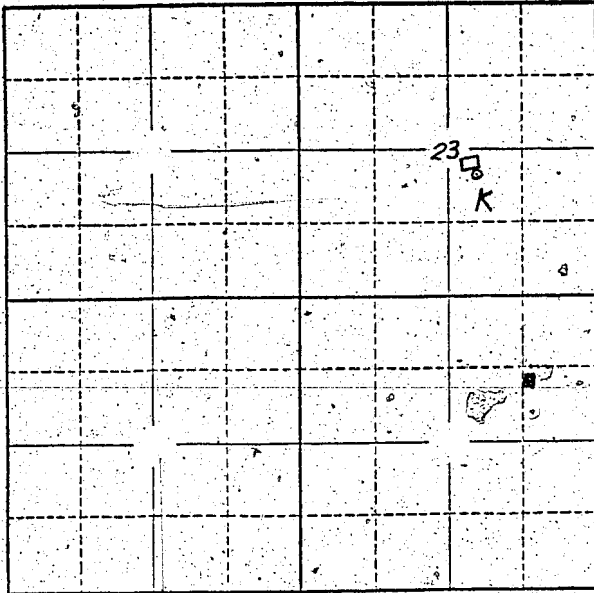

Locate well and acreage of irrigated land on plat.

Scale: 2" = 1 Mile

See Note on preceding page

STATE OF OREGON

County of multnomah } ss.

I, L V LUKAS being first duly sworn, do hereby certify that I have read the foregoing Registration Statement and that all of the items therein contained are true to the best of my knowledge and belief.

*[Handwritten Signature]*  
(Signature of Registrant)

Subscribed and sworn to before me this 1st day of August, 1958

My commission expires NOTARY PUBLIC FOR OREGON  
My Commission Expires Sept. 23, 1960

*[Handwritten Signature]*  
(Notary Public)

(SEAL)

**CERTIFICATE OF REGISTRATION**

STATE OF OREGON } ss.  
County of Marion

This is to certify that the foregoing Registration Statement was received in the office of the State Engineer on the 4th day of August, 1958, at 2:00 o'clock A.M. and has been duly recorded in said office in Book No. 15 of Registration Statements on page GR-3716

Witness my hand this 20th day of October, 1959

*[Handwritten Signature: Lewis A. Stanley]*  
(State Engineer)

By \_\_\_\_\_ (Deputy)

\$15.00