


Township 14S Range 5W, W.M.

North

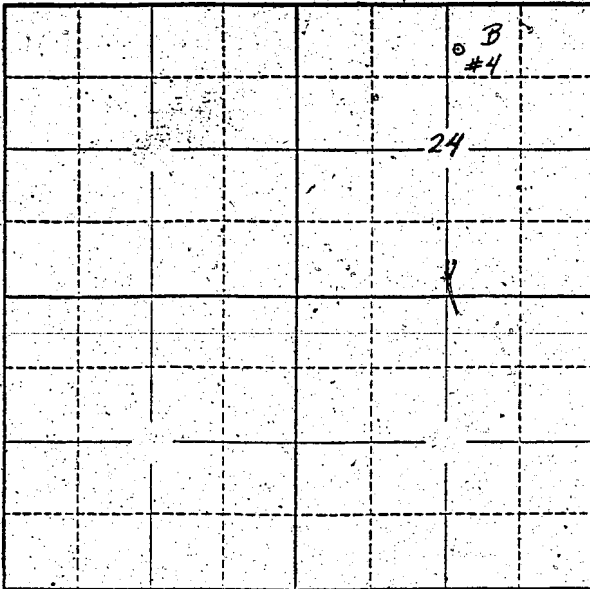

Locate well and acreage of irrigated land on plat.

Scale: 2" = 1 Mile

STATE OF OREGON

County of Wana } ss.

I, Guy M. Gilmore, being first duly sworn, do hereby certify that I have read the foregoing Registration Statement and that all of the items therein contained are true to the best of my knowledge and belief.

Guy M. Gilmore
(Signature of Registrant)

Subscribed and sworn to before me this 29th day of July, 1958

My commission expires March 14, 1962
Herman Boyard
(Notary Public)

(SEAL)

CERTIFICATE OF REGISTRATION

STATE OF OREGON } ss.
County of Marion

This is to certify that the foregoing Registration Statement was received in the office of the State Engineer on the 4th day of August, 1958, at 8.00 o'clock A. M. and has been duly recorded in said office in Book No. 15 of Registration Statements on page GR-3722

Witness my hand this 20th day of October, 1959

Laura A. Stanley
(State Engineer)

By _____ (Deputy)

\$15.00