


SECT 4 1/2

Township 8 S Range 3 W, W.M.

North

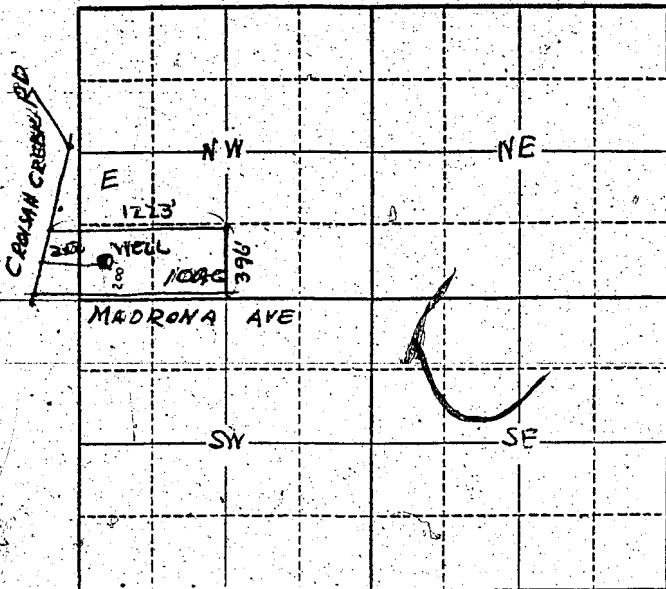

Locate well and acreage of irrigated land on plat.

Scale: 2" = 1 Mile

STATE OF OREGON

County of Marion } ss.

I, Danver Young, being first duly sworn, do hereby certify that I have read the foregoing Registration Statement and that all of the items therein contained are true to the best of my knowledge and belief.

Danver Young
(Signature of Registrant)

Subscribed and sworn to before me this 14th day of August, 19 58.

My commission expires Sept 12 1959

Alvin J. Waltem
(Notary Public)

(SEAL)

CERTIFICATE OF REGISTRATION

STATE OF OREGON }
County of Marion } ss.

This is to certify that the foregoing Registration Statement was received in the office of the State Engineer on the 14th day of August, 19 58, at 3:30 o'clock P. M. and has been duly recorded in said office in Book No. 15 of Registration Statements on page OR 3725

Witness my hand this 20th day of October, 19 59.

Lewis A. Stanley
(State Engineer)

By _____ (Deputy)

GR 3725

\$ 15.00