


Neither the inclusion nor the omission of any information concerning any wells in this or any other registration statement shall constitute a waiver or abandonment of any right of the United States to the use of water.

Township 18 S. Range 3 W. W.M.

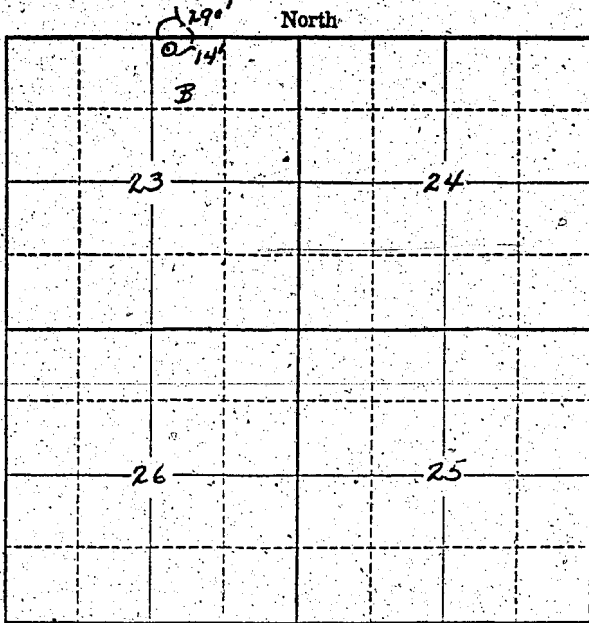

Locate well and acreage of irrigated land on plat.  
Scale: 2" = 1 Mile

STATE OF OREGON

County of Multnomah } ss.

I, James E. Dowling being first duly sworn, do hereby certify that I have read the foregoing Registration Statement and that all of the items therein contained are true to the best of my knowledge and belief.

James E. Dowling  
Principal Title (Signature of Registrant) Officer

Subscribed and sworn to before me this 31 day of July, 1958

My commission expires 3/12/1962

E. J. Kelleys  
(Notary Public)

(SEAL)

**CERTIFICATE OF REGISTRATION**

STATE OF OREGON }  
County of Marion } ss.

This is to certify that the foregoing Registration Statement was received in the office of the State Engineer on the 1st day of August, 1958, at 1:00 o'clock A. M. and has been duly recorded in said office in Book No. 15 of Registration Statements on page GR-3730

Witness my hand this 20<sup>th</sup> day of October, 1959

\$ 20.00

Laura A. Stanley  
(State Engineer)

By \_\_\_\_\_ (Deputy)

GR 3730