Township 15S Range 4W W.M.

North

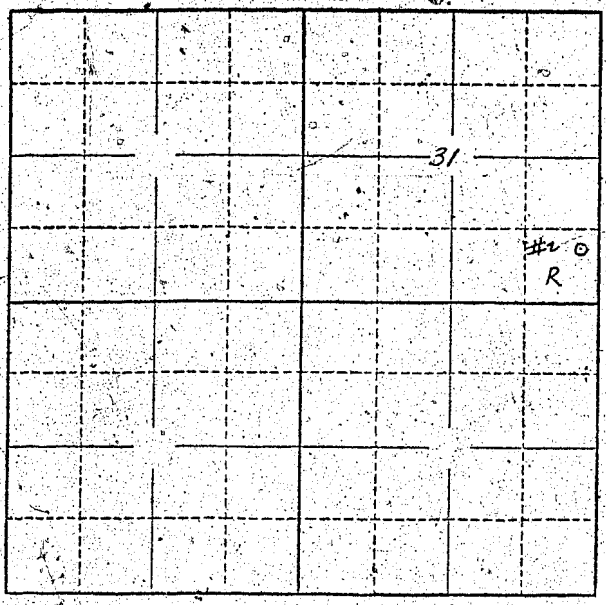


Locate well and acreage of irrigated land on plat.

Scale: 2" = 1 Mile

STATE OF OREGON
County of Lane } ss.

I, Gertrude Sanders, Clerk, Lane County School District No 69, being first duly sworn, do hereby certify that I have read the foregoing Registration Statement and that all of the items therein contained are true to the best of my knowledge and belief.

Gertrude Sanders Clerk
(Signature of Registrant)

Subscribed and sworn to before me this 31st day of July, 1958.

My commission expires April 11, 1960.

Helen Shurbath
(Notary Public)

(SEAL)

## CERTIFICATE OF REGISTRATION

STATE OF OREGON
County of Marion } ss.

This is to certify that the foregoing Registration Statement was received in the office of the State Engineer on the 1 day of August, 1958, at 8:00 o'clock A M. and has been duly recorded in said office in Book No. 16 of Registration Statements on page GR-3993

Witness my hand this 15th day of February, 1960.

Hollis M. Dunlap
(State Engineer)

By
(Deputy)

$25.00

GR 3993