


Township 17S Range 3W North

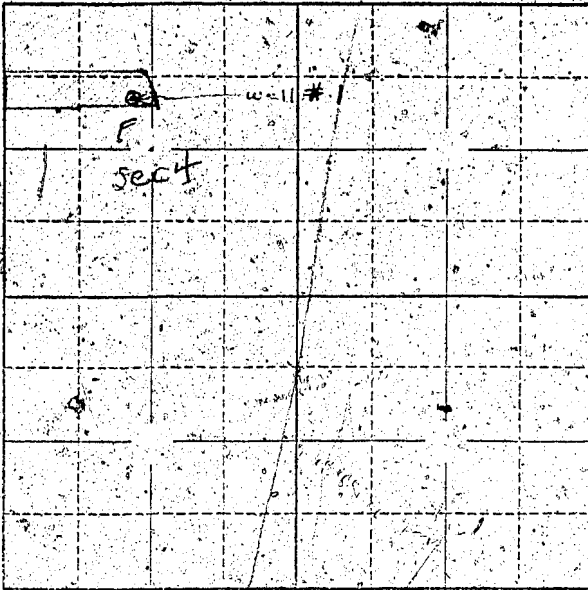

Locate wall and acreage of irrigated land on plat.
Scale: 2" = 1 Mile.

STATE OF OREGON

County of Linn } ss.

I, Forest G. Mickelson, being first duly sworn, do hereby certify that I have read the foregoing Registration Statement and that all of the items therein contained are true to the best of my knowledge and belief.

Forest G. Mickelson
(Signature of Registrant)

Subscribed and sworn to before me this 1st day of August, 1958.

My commission expires July 1962

(Notary Public)

(SEAL)

CERTIFICATE OF REGISTRATION

STATE OF OREGON

County of Marion } ss.

This is to certify that the foregoing Registration Statement was received in the office of the State Engineer on the 1 day of August, 1958, at 8:00 o'clock A. M. and has been duly recorded in said office in Book No. 16 of Registration Statements on page GR-3843

~~Construction shall be completed by 19 and the water completed applied to beneficial use by 19~~

Witness my hand this 28 day of December, 1959

Laura W. Stebbins
(State Engineer)

By

GR-3843

(Deputy)

\$15.00