


North

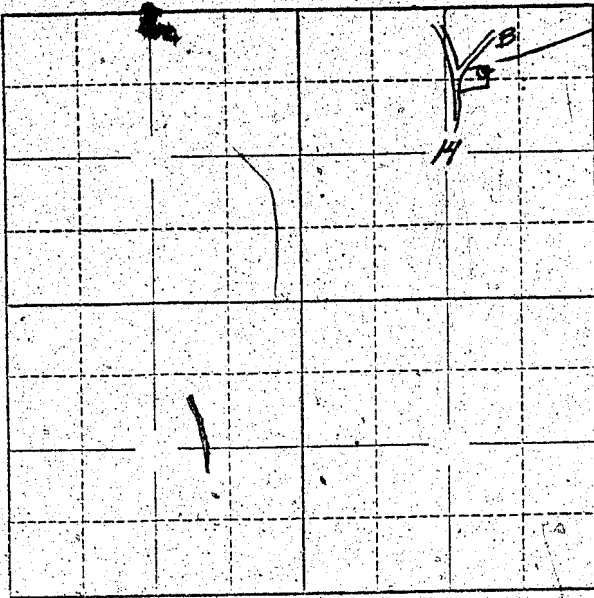

Well located

Section

Locate well and acreage of irrigated land on plat.  
Scale: 2" = 1 Mile

STATE OF OREGON

County of Marion } ss.

I, Glenn W. Hansberry, being first duly sworn, do hereby certify that I have read the foregoing Registration Statement and that all of the items therein contained are true to the best of my knowledge and belief.

*Glenn W. Hansberry*  
(Signature of Registrant)

Subscribed and sworn to before me this 4 day of August 1958

My commission expires NOTARY PUBLIC FOR OREGON

My Commission Expires Dec. 14, 1961

(Notary Public)

(SEAL)

CERTIFICATE OF REGISTRATION

STATE OF OREGON

County of Marion } ss.

This is to certify that the foregoing Registration Statement was received in the office of the State Engineer on the 4th day of August, 1958, at 8:00 o'clock A.M. and has been duly recorded in said office in Book No. 17 of Registration Statements on page 4070

~~Construction shall be completed by 1960 and the water completed shall be beneficial by 1960~~

Witness my hand this 16th day of May, 1960

*Lewis A. Stanley*  
(State Engineer)

By (Deputy)

\$ 20.00