


Township 55 Range 14 W.M. North

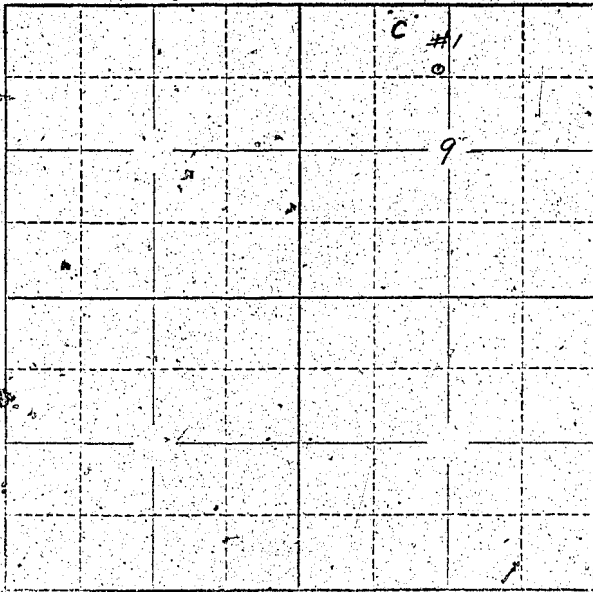

Locate well and acreage of irrigated land on plat  
Scale: 2" = 1 Mile

STATE OF OREGON

County of \_\_\_\_\_ } ss.

I, Amos E. Reed, Superintendent, being first duly sworn, do hereby certify that I have read the foregoing Registration Statement and that all of the items therein contained are true to the best of my knowledge and belief.

Amos E. Reed  
(Signature of Registrant)

Subscribed and sworn to before me this 27th day of November, 1959

My commission expires May 30, 1963

[Signature]  
(Notary Public)

(SEAL)

**CERTIFICATE OF REGISTRATION**

STATE OF OREGON } ss.  
County of Marion

This is to certify that the foregoing Registration Statement was received in the office of the State Engineer on the 4th day of August, 1958, at 4:30 o'clock A.M. and has been duly recorded in said office in Book No. 16 of Registration Statements on page GR 3837

~~xx Construction shall be completed by xxxxxxxx and the water completed applied to beneficial use by xxxxxxxx~~

Witness my hand this 4th day of December, 1959

Lewis A. Stanley  
(State Engineer)

\$ 38.95

By \_\_\_\_\_ (Deputy)

GR 3837