


North

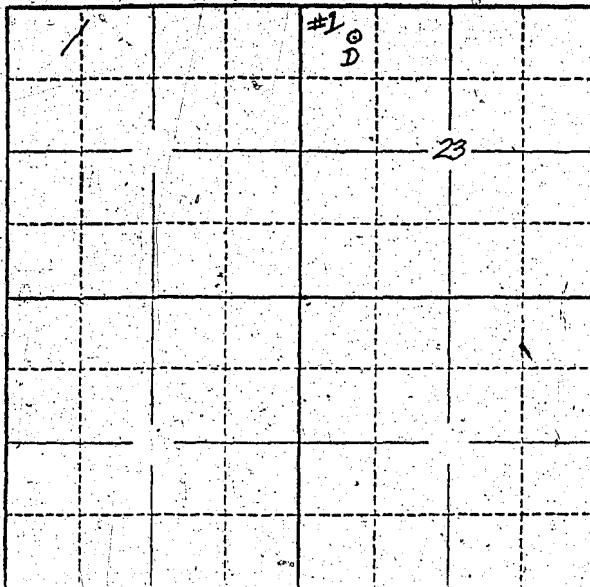

Locate well and acreage of irrigated land on plat.

Scale: 2" = 1 Mile

STATE OF OREGON

County of Lane } ss.

I, Thayer Dickey, being first duly sworn, do hereby certify that I have read the foregoing Registration Statement and that all of the items therein contained are true to the best of my knowledge and belief.

Gracia R. Rattay
Thayer Dickey
(Signature of Registrant)

Subscribed and sworn to before me this 1st day of August, 1958

My commission expires March 13 1961 Dwight D. Paul
(Notary Public)

(SEAL)

CERTIFICATE OF REGISTRATION

STATE OF OREGON }
County of Marion } ss.

This is to certify that the foregoing Registration Statement was received in the office of the State Engineer on the 4th day of August, 1958 at 1⁰⁰ o'clock P. M. and has been duly recorded in said office in Book No. 16 of Registration Statements on page GR 4019

Witness my hand this 15th day of March, 1960

Luvis G. Stanley
(State Engineer)

By _____
(Deputy)

\$15.00