


North

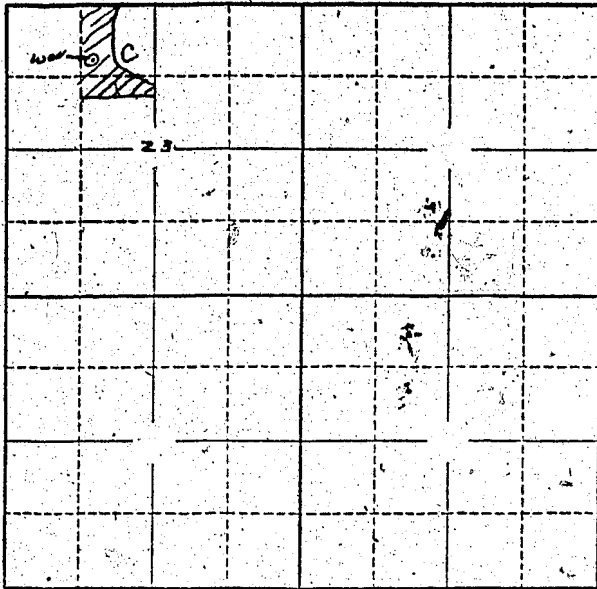

Locate well and acreage of irrigated land on plat.

Scale: 2" = 1 Mile

STATE OF OREGON

County of Jane } ss.

I, Carl Kirk being first duly sworn, do hereby certify that I have read the foregoing Registration Statement and that all of the items therein contained are true to the best of my knowledge and belief.

Carl Kirk  
(Signature of Registrant)

Subscribed and sworn to before me this 31<sup>st</sup> day of July, 1958

My commission expires April 11, 1960 Wm. Stuckert  
(Notary Public)

(SEAL)

**CERTIFICATE OF REGISTRATION**

STATE OF OREGON }  
County of Marion } ss.

This is to certify that the foregoing Registration Statement was received in the office of the State Engineer on the 1<sup>st</sup> day of August, 1958, at 2:00 o'clock A. M. and has been duly recorded in said office in Book No. 14 of Registration Statements on page GR-3418

Witness my hand this 20<sup>th</sup> day of August, 1959

Luvia A. Stanley  
(State Engineer)

By \_\_\_\_\_  
(Deputy)

\$ 15.00